


# PALO ALTO RESIDENCE

## GENERAL NOTES

## SYMBOLS

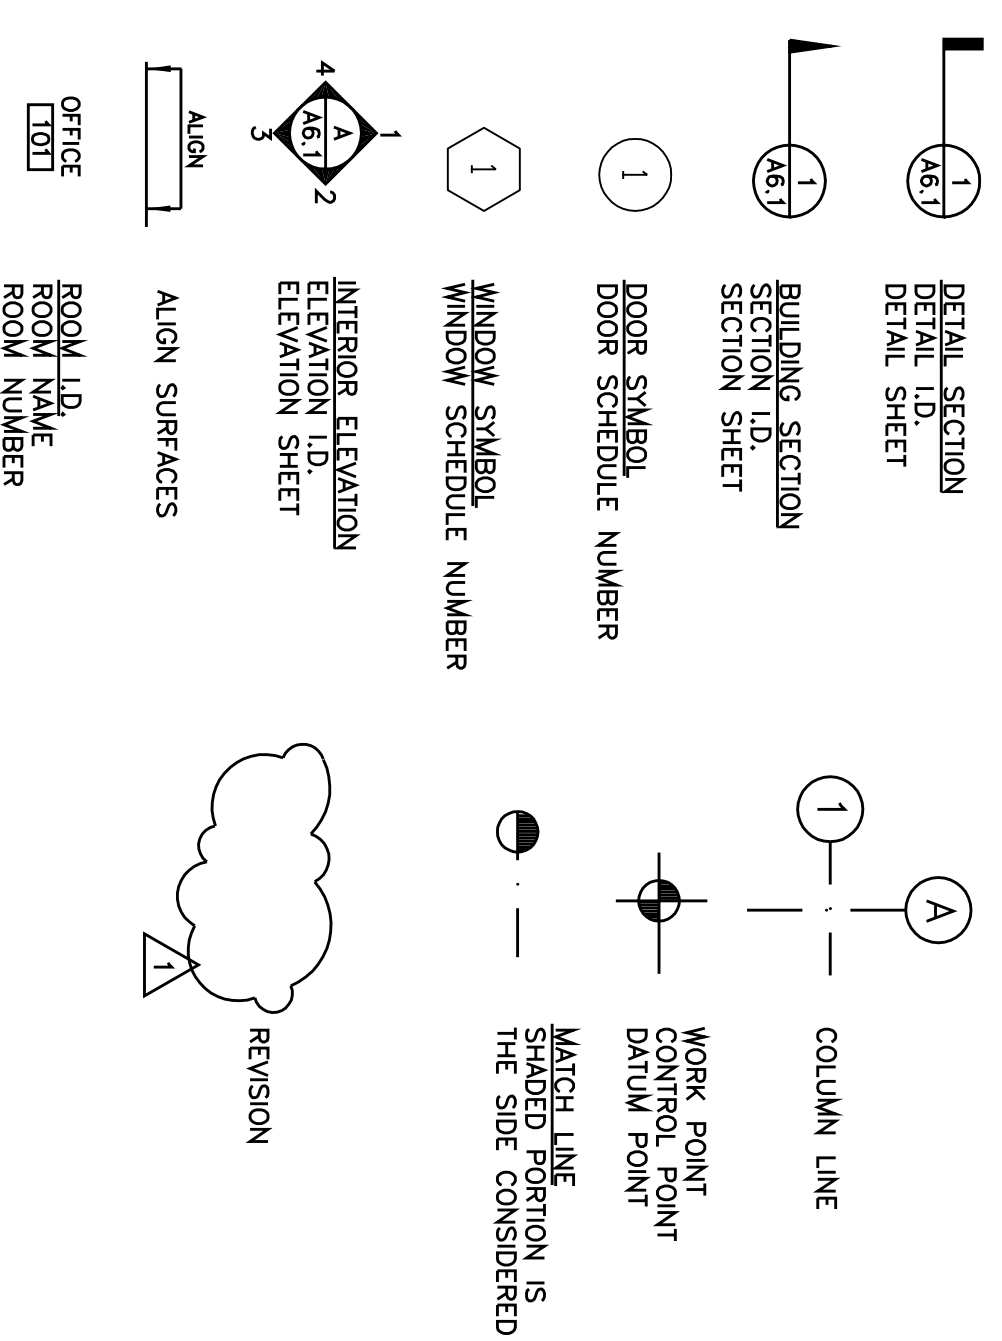


## PROPOSED WORK:

### AREAS:

	EXISTING TOTAL:	PROPOSED TOTAL:	GROSS A.:
BASEMENT	258 sq. ft.		
1ST FLOOR	1040 sq. ft.		
2ND FLOOR	870 sq. ft.		
3RD FLOOR	412 sq. ft.		
TOTAL:	2580 sq. ft.		

PARCEL #:  
 ZONE: R  
 CONSTRUCTION TYPE: V  
 OCCUPANCY TYPE: R

LOCATION:  
 PALO ALTO, CA.

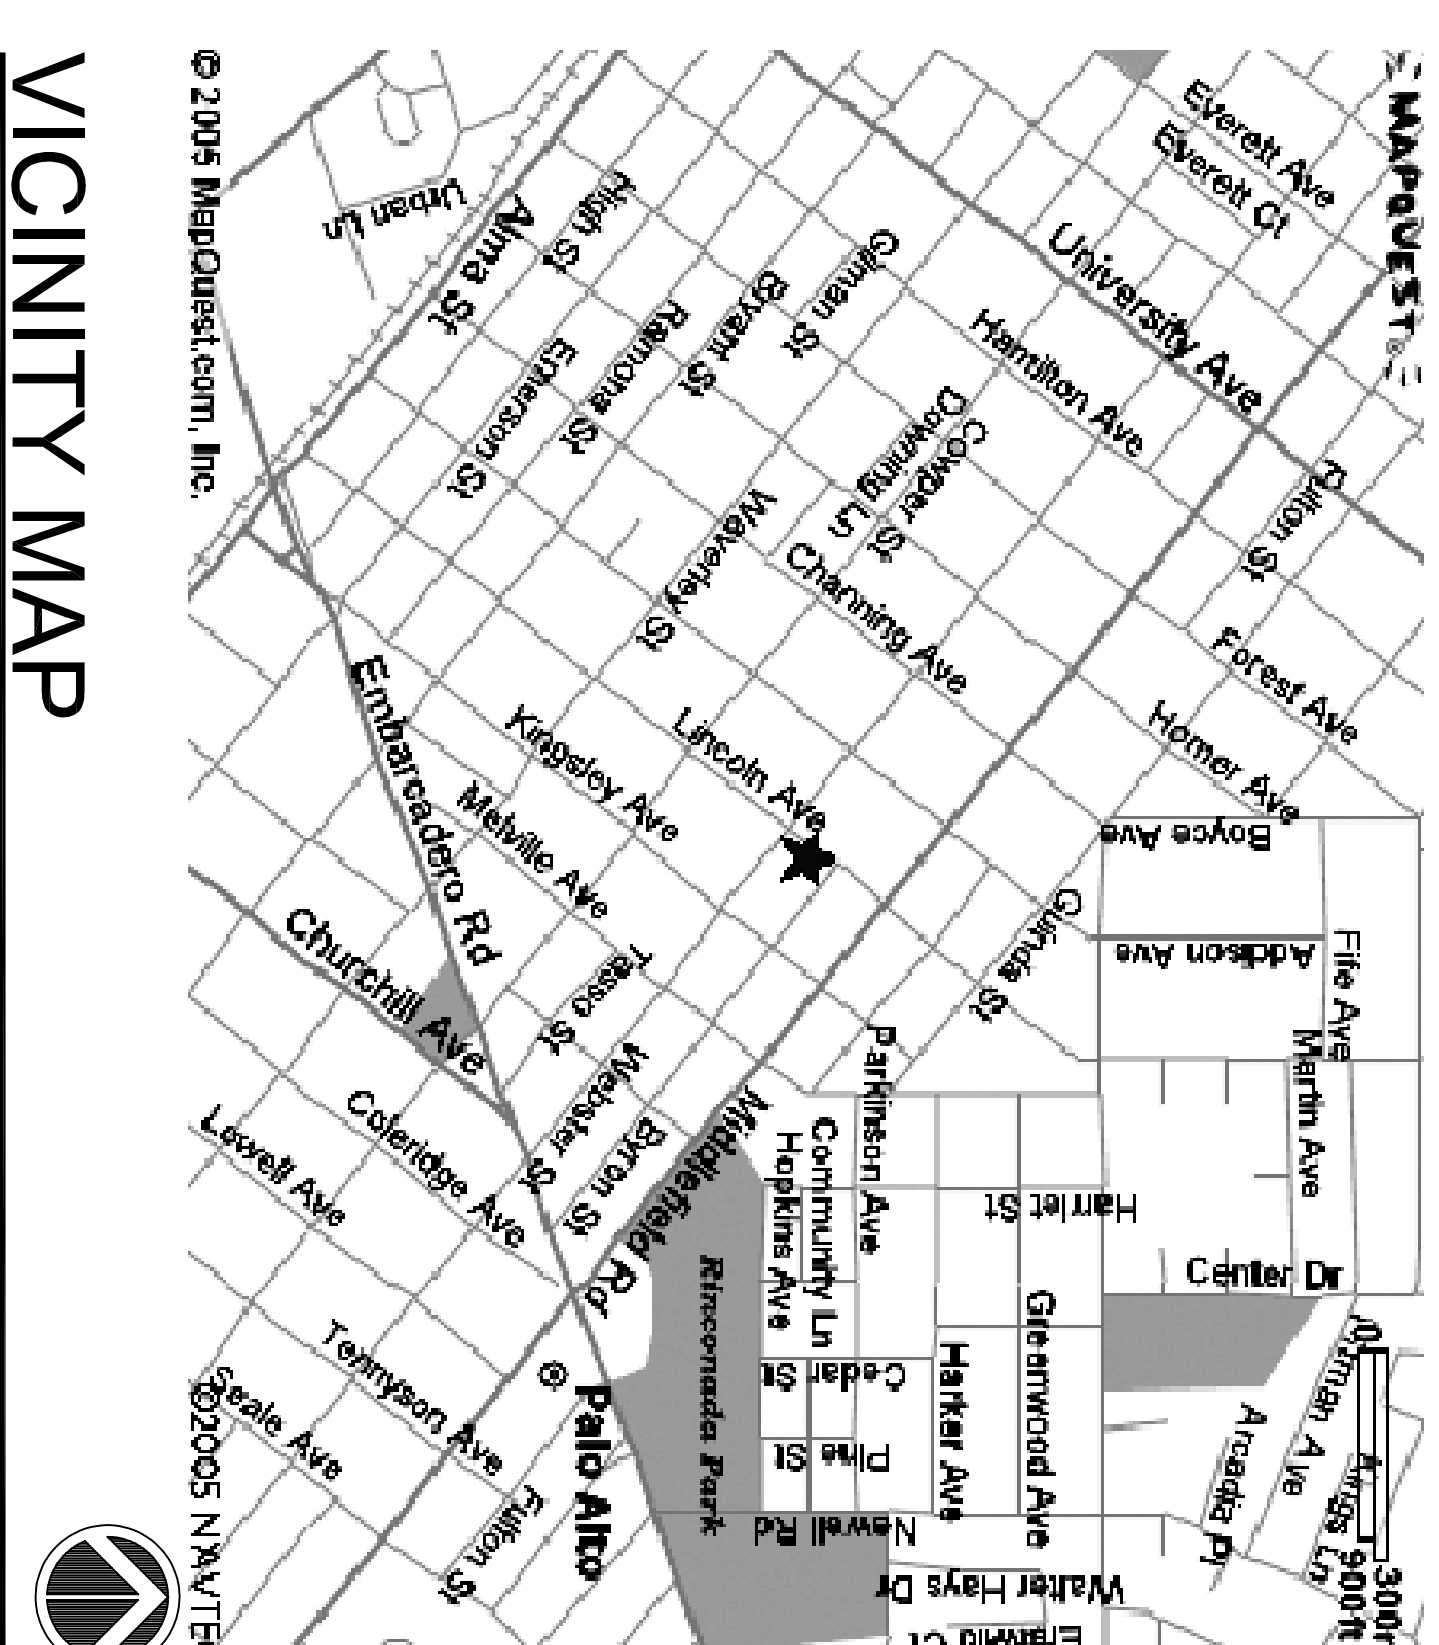


## VICINITY MAP

SCALE: N.T.S.


## DRAWING INDEX:

- A0.0 COVER PAGE
- A2.0 (E) BASEMENT AND 1ST FLOOR PLANS
- A2.1 (E) 2ND AND 3RD FLOOR PLANS
- A3.0 (E) ELEVATIONS
- A4.0 (E) SECTIONS
- E1.0 (E) BASEMENT AND 1ST FLOOR ELECTRICAL PLANS
- E1.1 (E) 2ND AND 3RD FLOOR ELECTRICAL PLANS

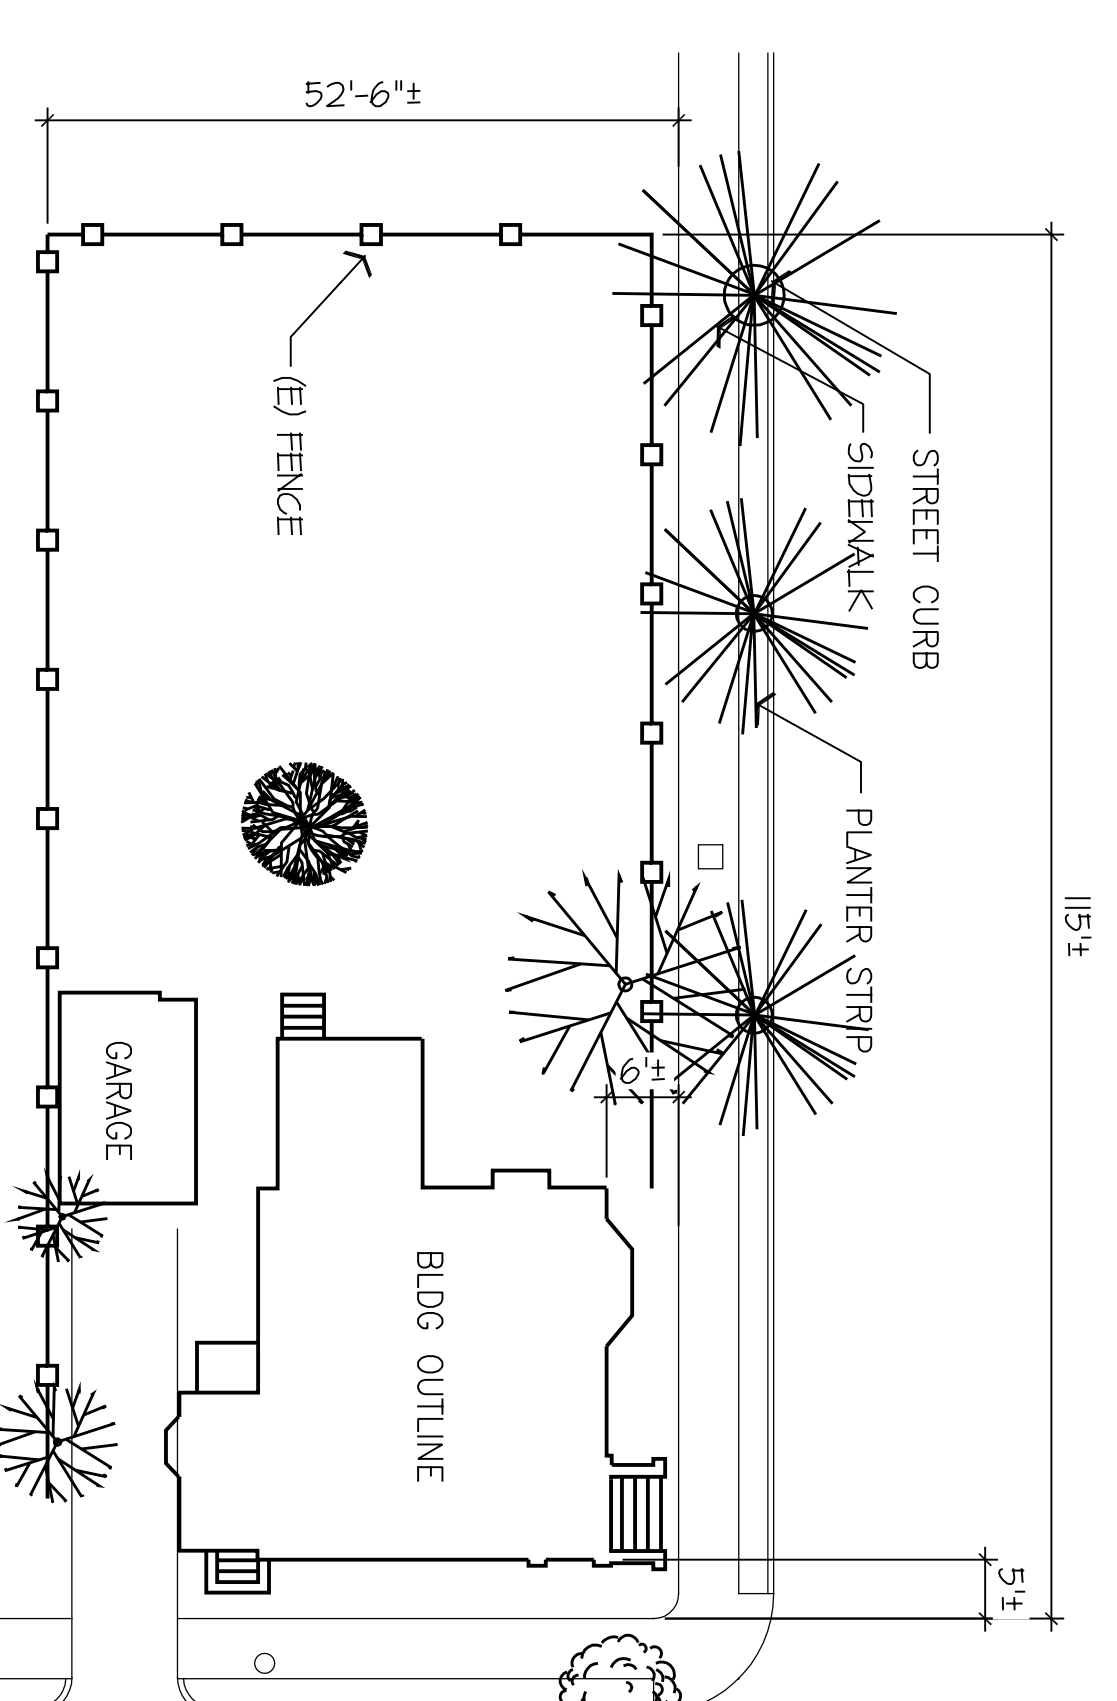

## SITE PLAN

SCALE: 1/16" = 1'-0"

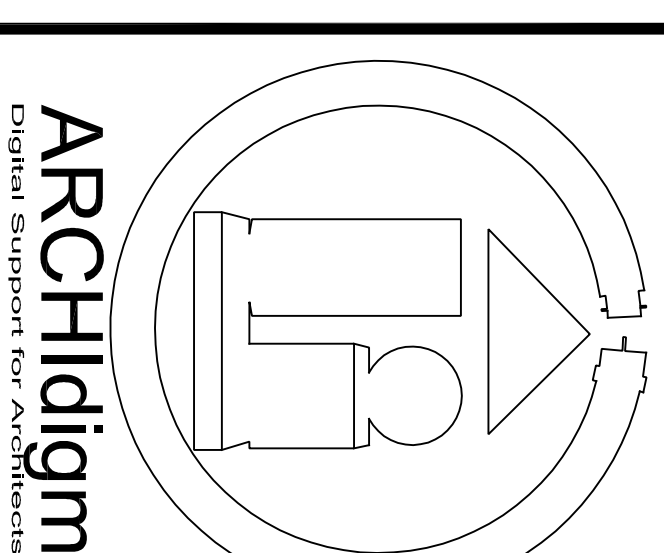

PROJECT:  
**PALOT ALTO RESIDENCE**  
 PALO ALTO, CA.


DATE:  
 SCALE: AS NOTED  
 DRAWING TITLE:  
**COVER PAGE**  
 SHEET NO.

# A0.0


SHEET\_A0.0

**GENERAL NOTES:**

- EXISTING DIMENSIONS ARE BASED ON INTERIOR FACE OF STUD U.O.N. A STANDARD TAPE MEASURE WAS USED AND ACTUAL VALUES MAY VARY WITHIN 1/4". ALL DIMENSIONS SHOULD BE FIELD VERIFIED PRIOR TO ANY CONSTRUCTION.

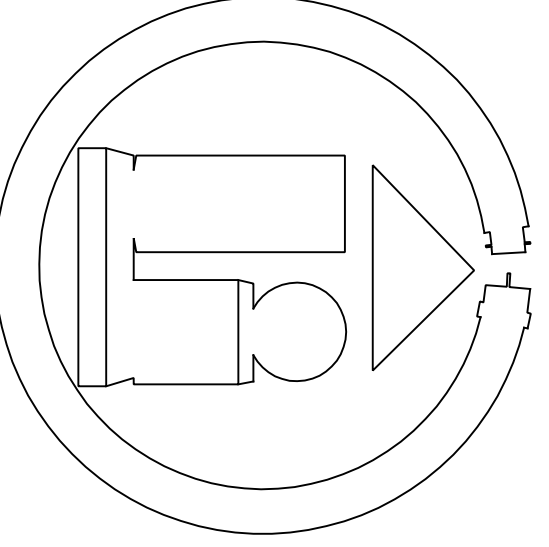


**ARCHIDIGM**  
Digital Support for Architects

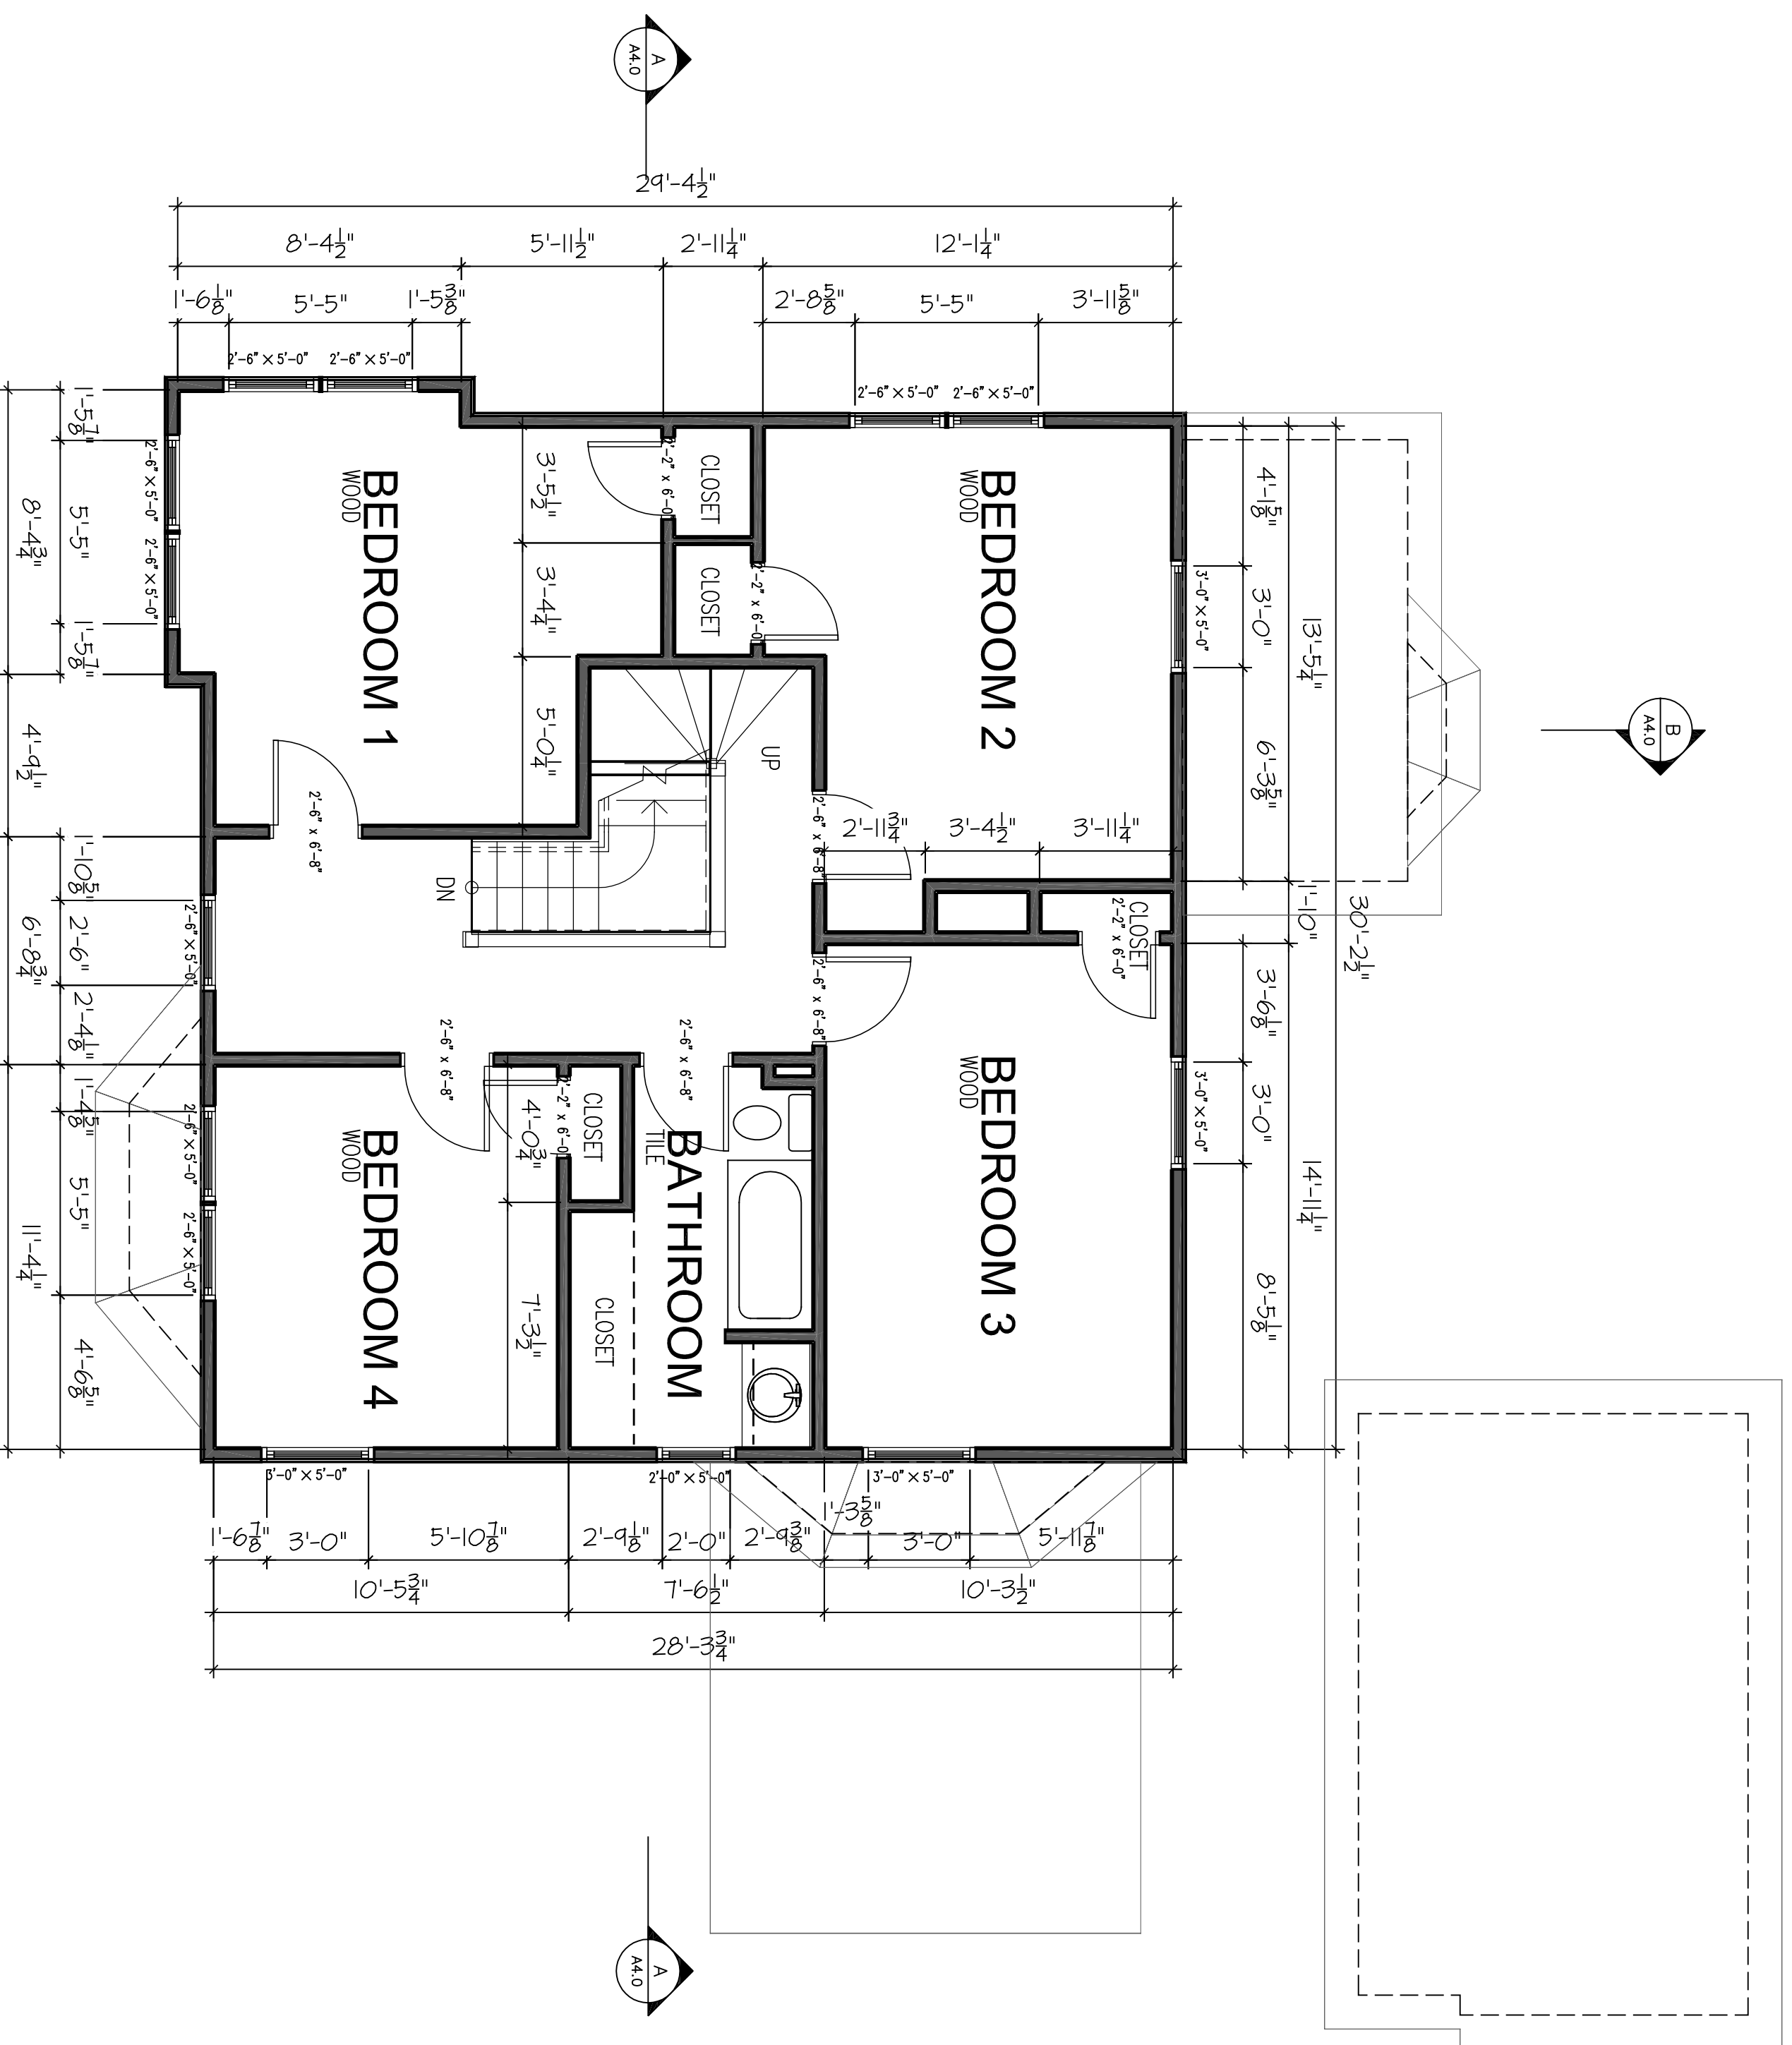

EXISTING  
**2ND FLOOR PLAN**

SCALE: 1/4" = 1'-0"

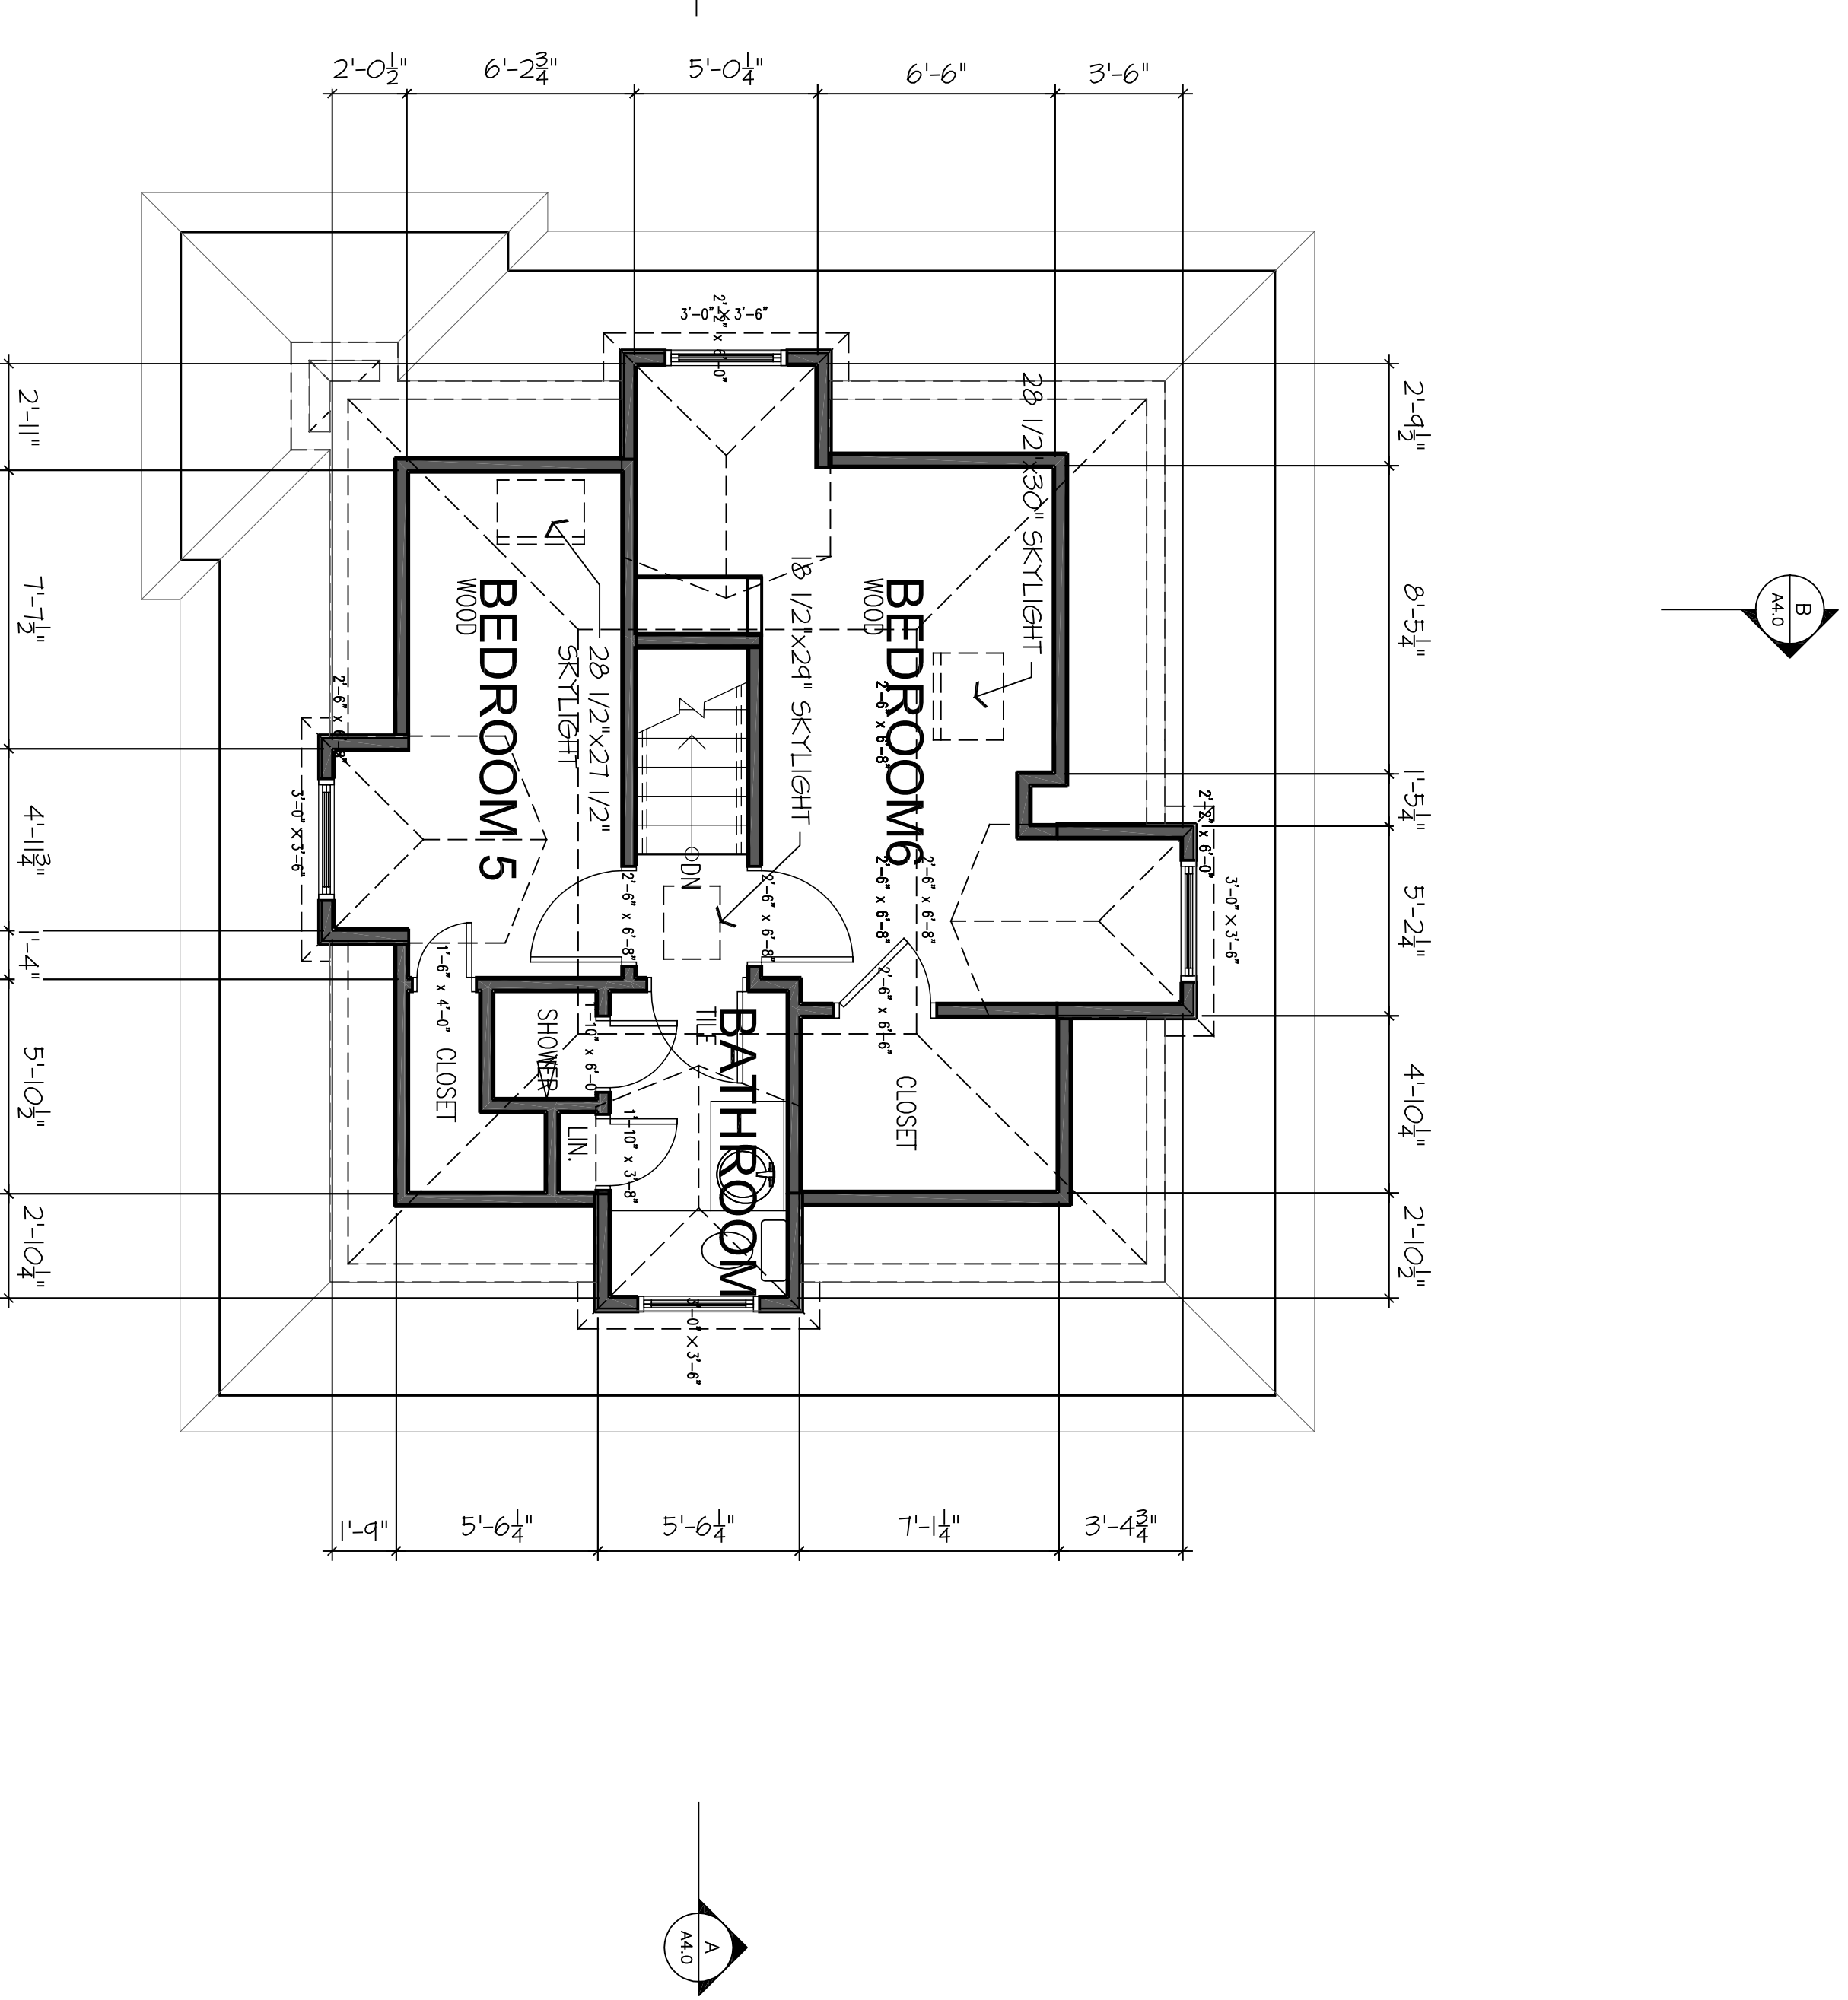

EXISTING  
**3RD FLOOR PLAN**

SCALE: 1/4" = 1'-0"




PROJECT:  
**PALOT ALTO RESIDENCE**  
PALO ALTO, CA.

DATE:  
SCALE: AS NOTED  
DRAWING TITLE:  
**EXISTING FLOOR PLAN**  
SHEET NO.


**A2.1**

SHEET A2.1

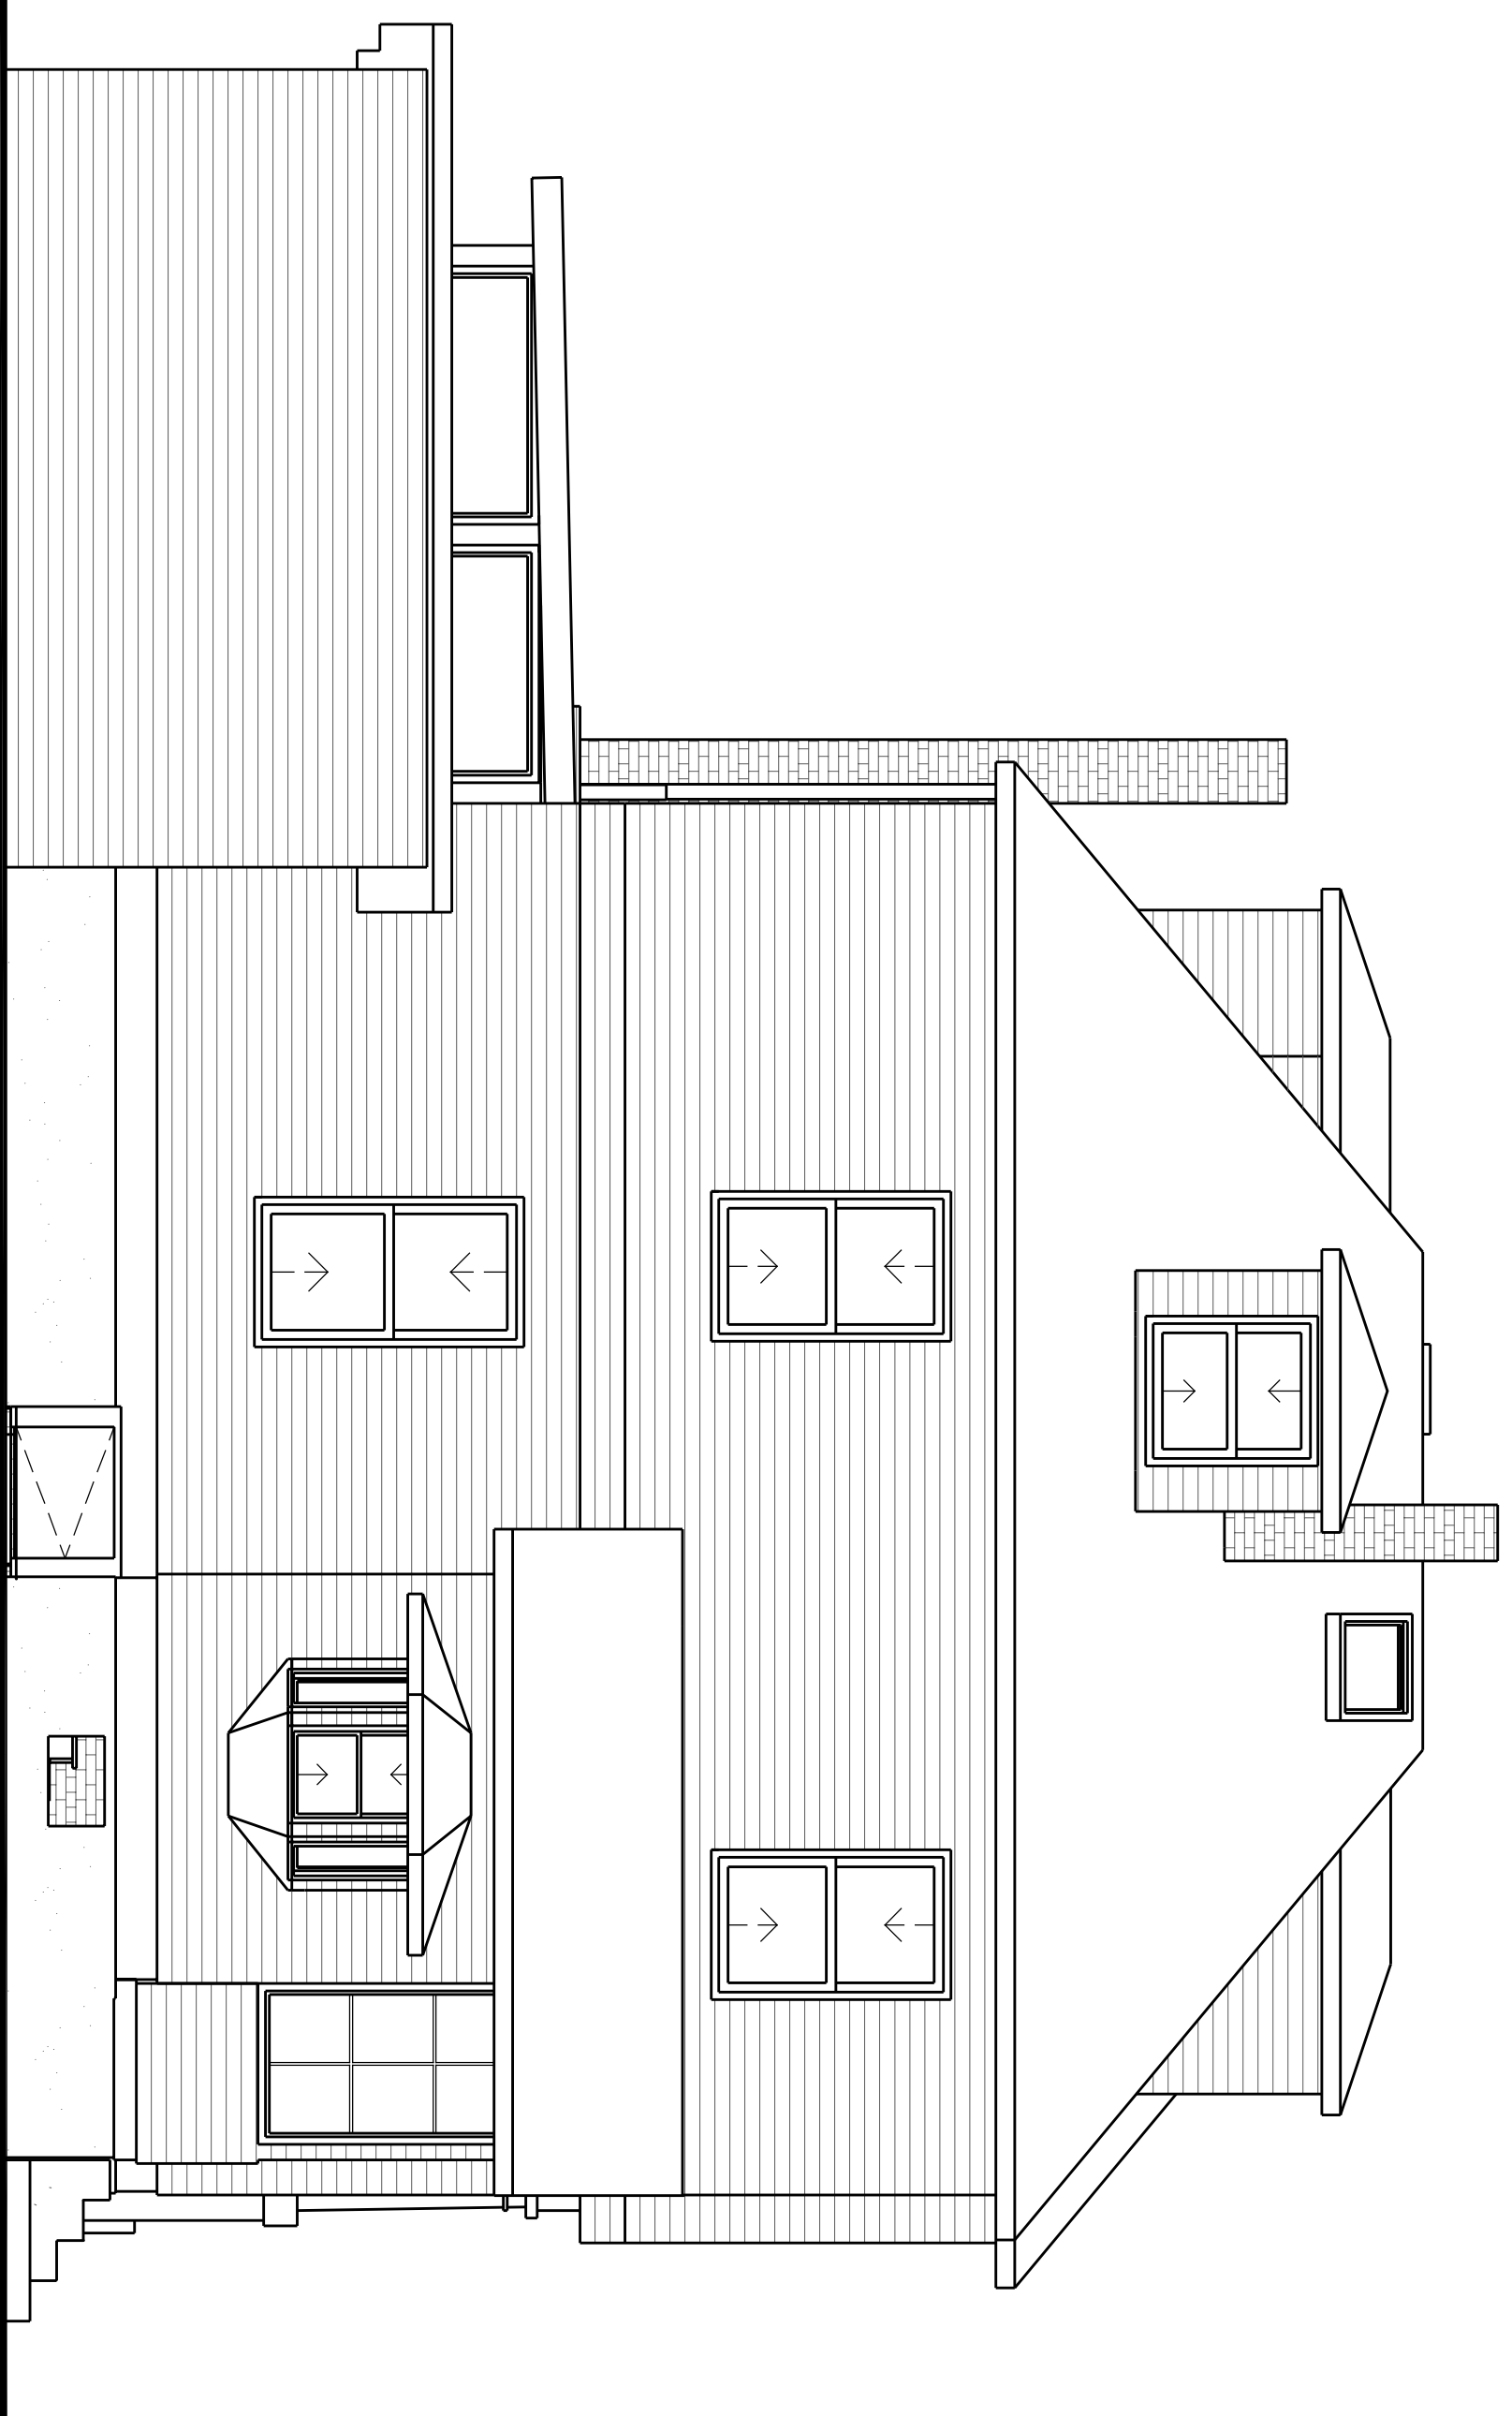


EXISTING  
SOUTH ELEVATION

SCALE: 1/4" = 1'-0"

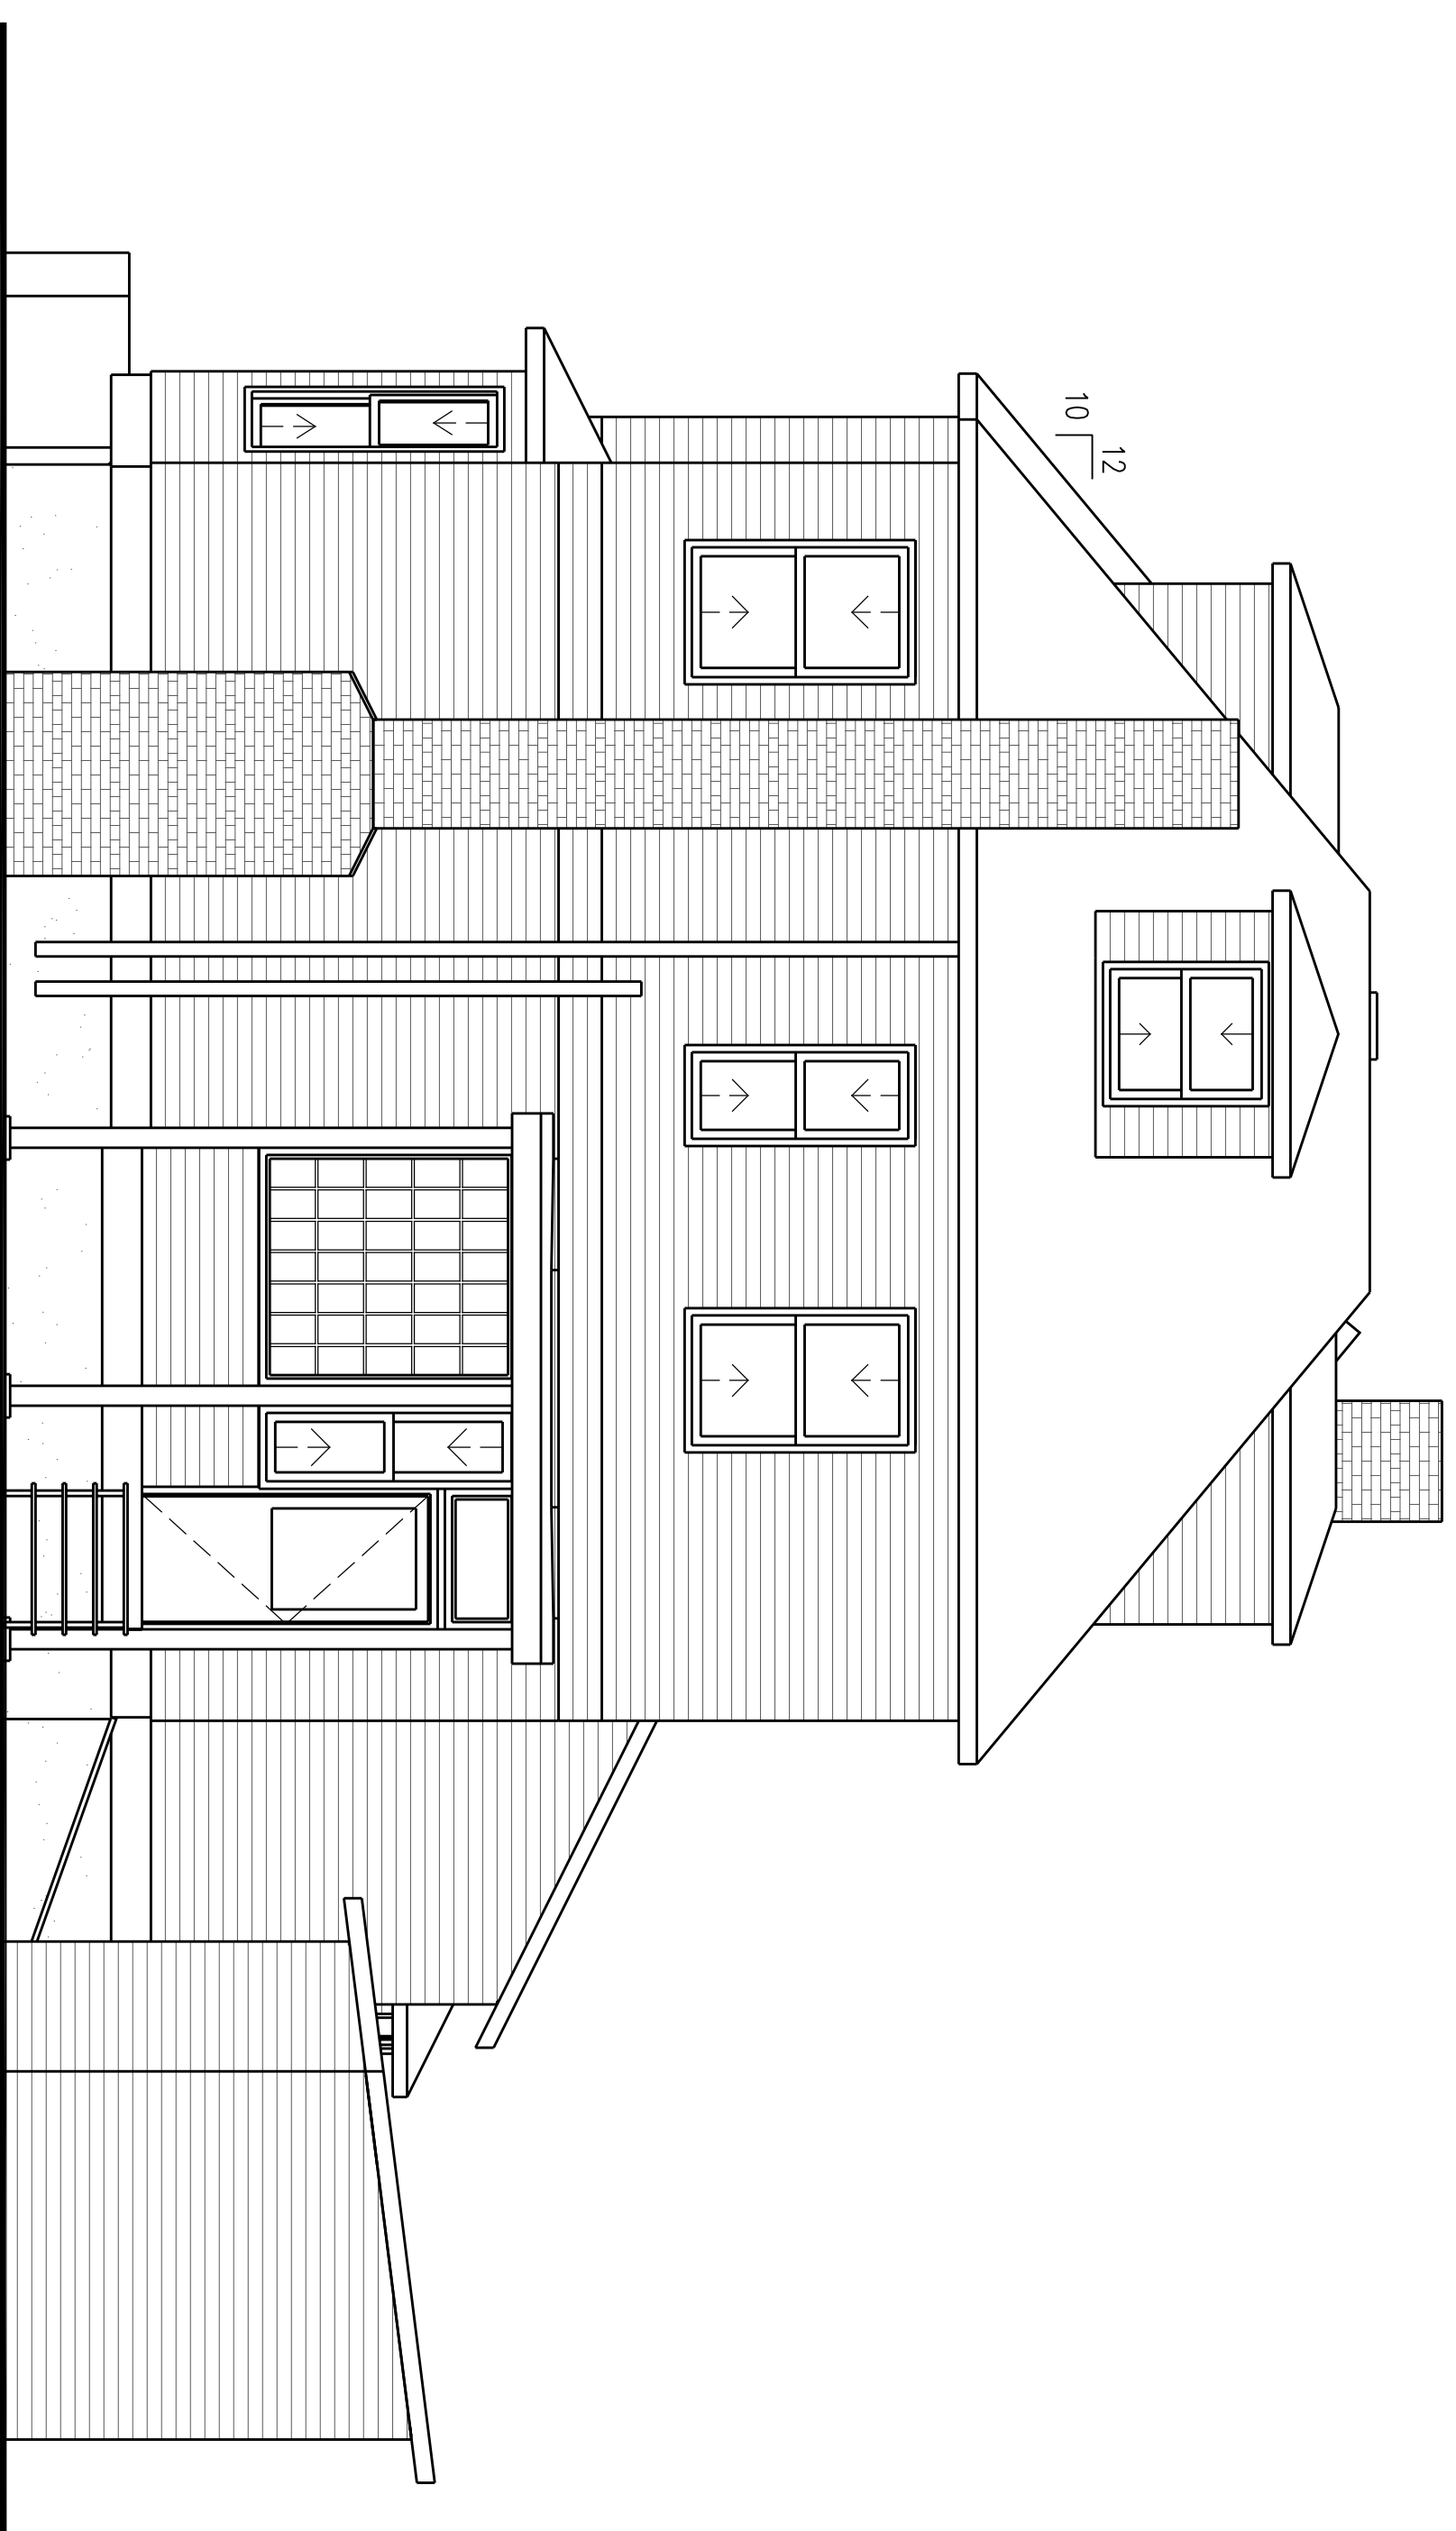


EXISTING  
WEST ELEVATION

SCALE: 1/4" = 1'-0"

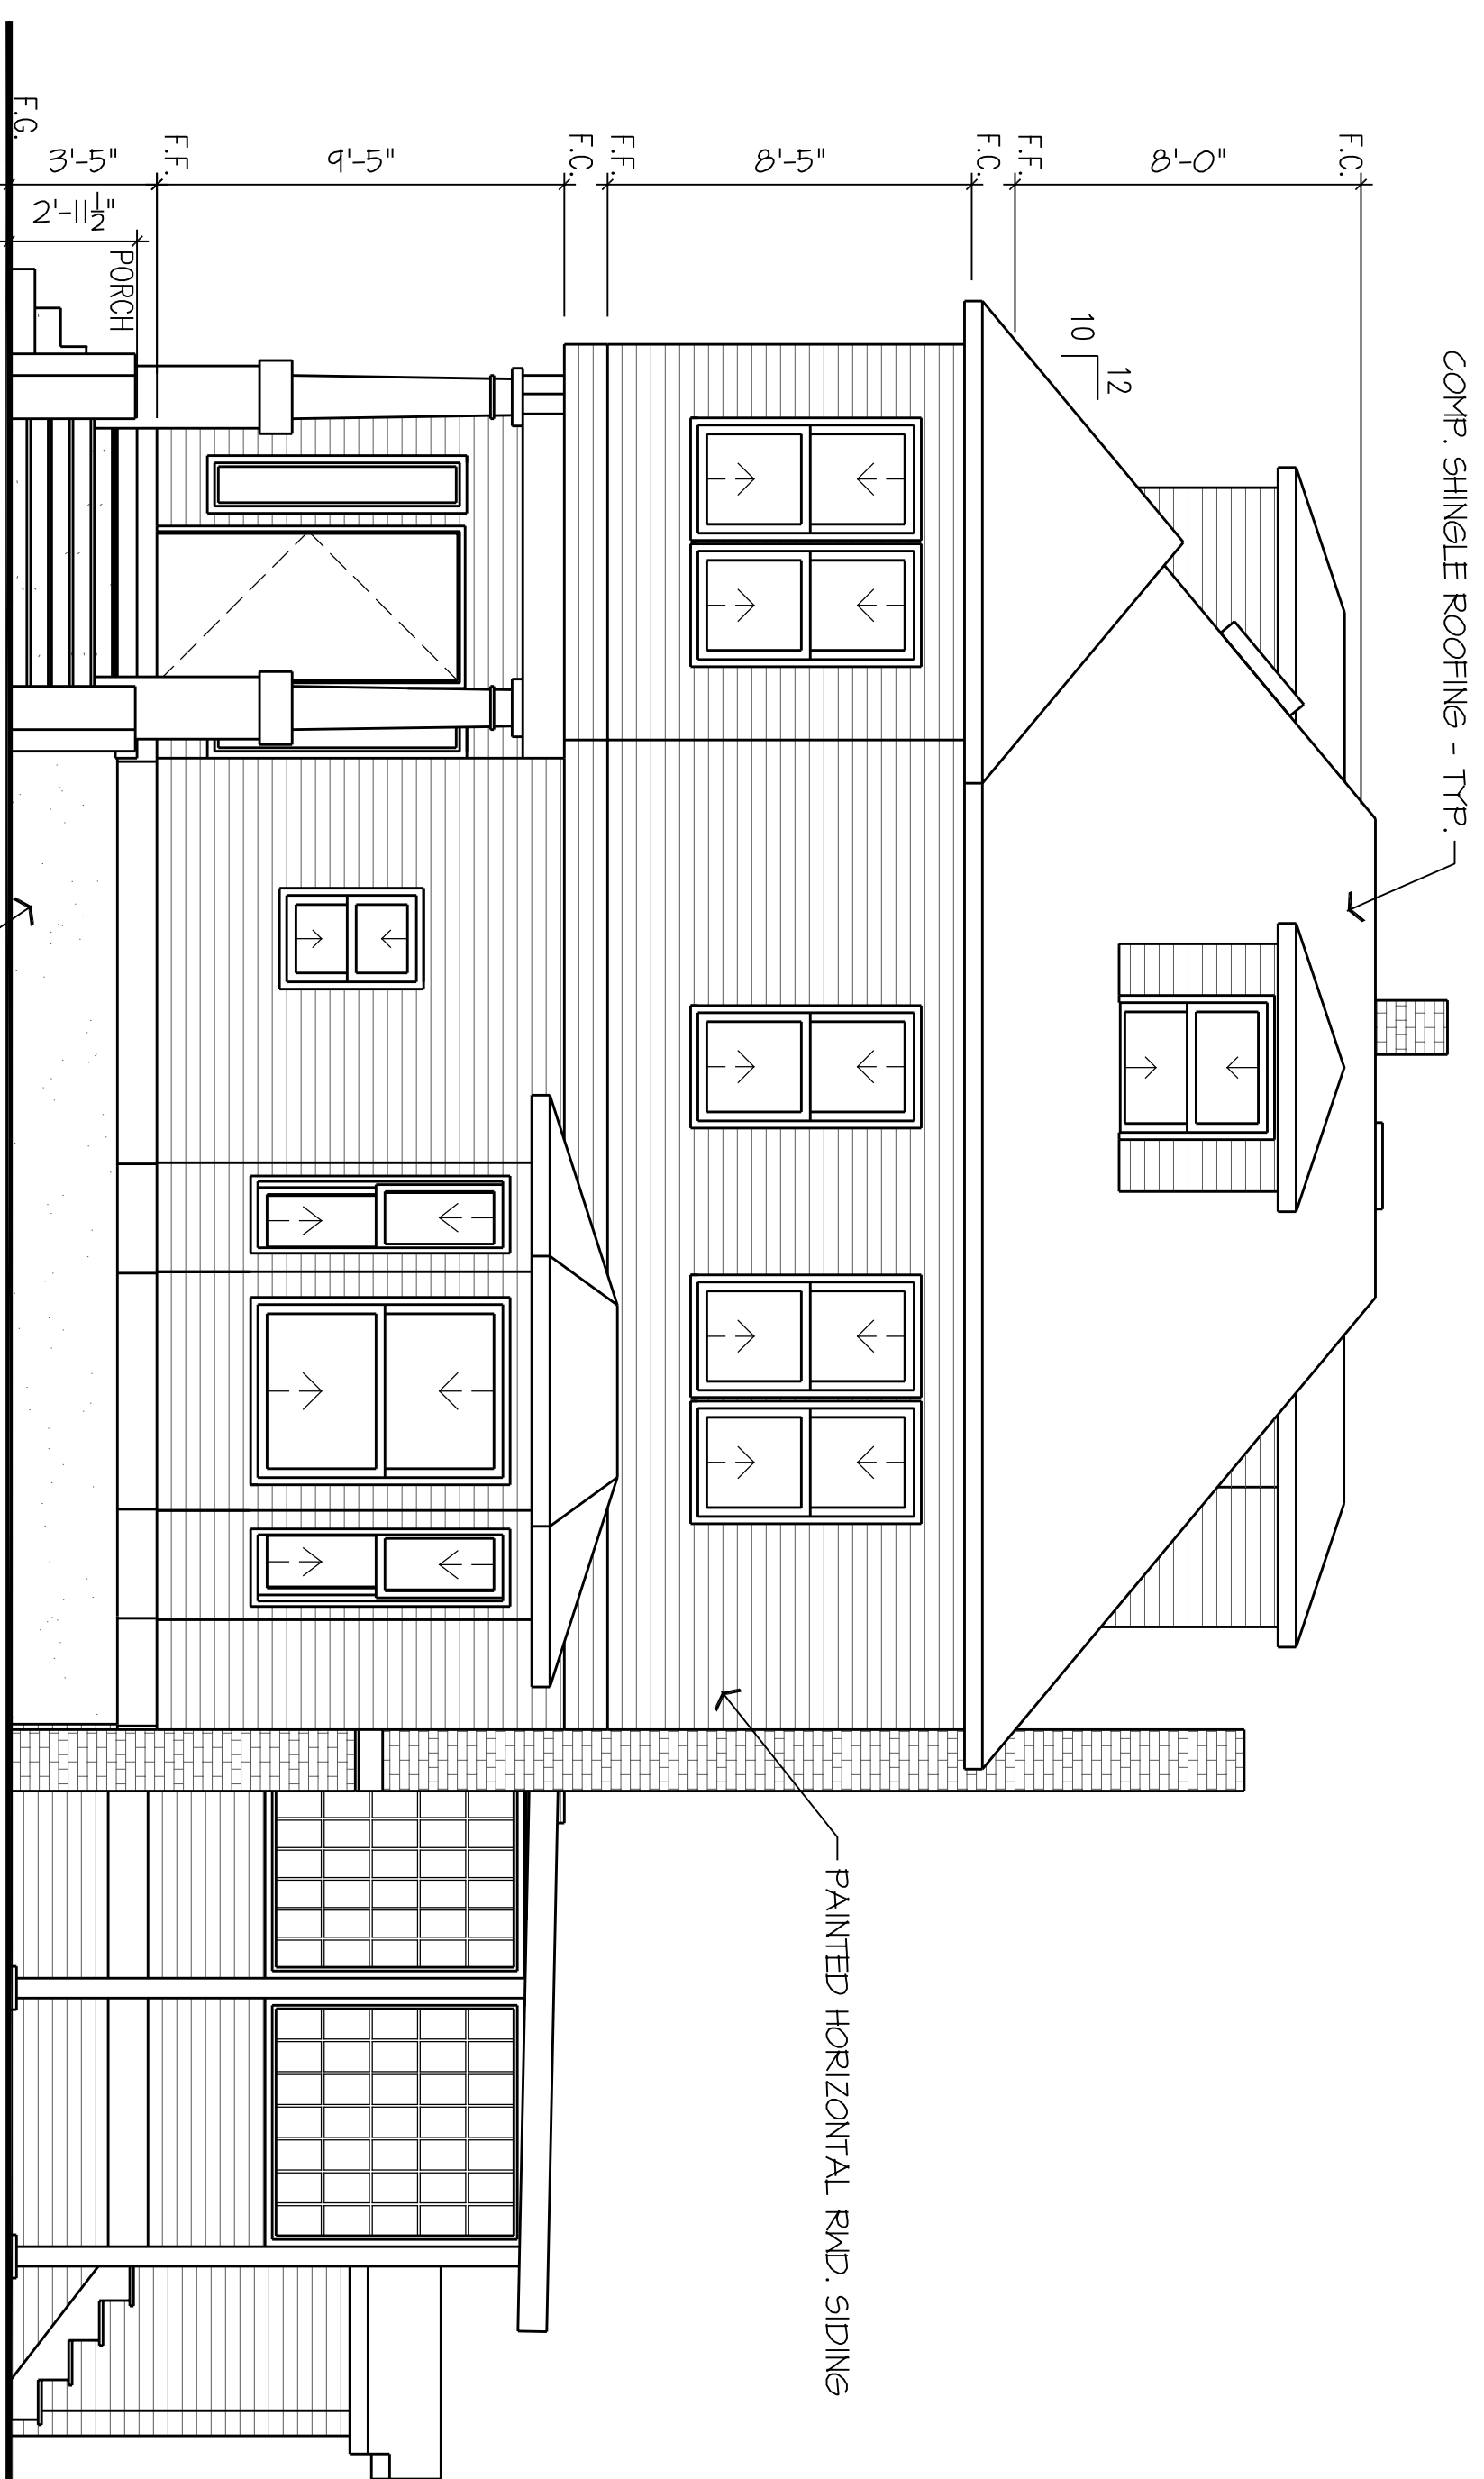


EXISTING  
NORTH ELEVATION

SCALE: 1/4" = 1'-0"

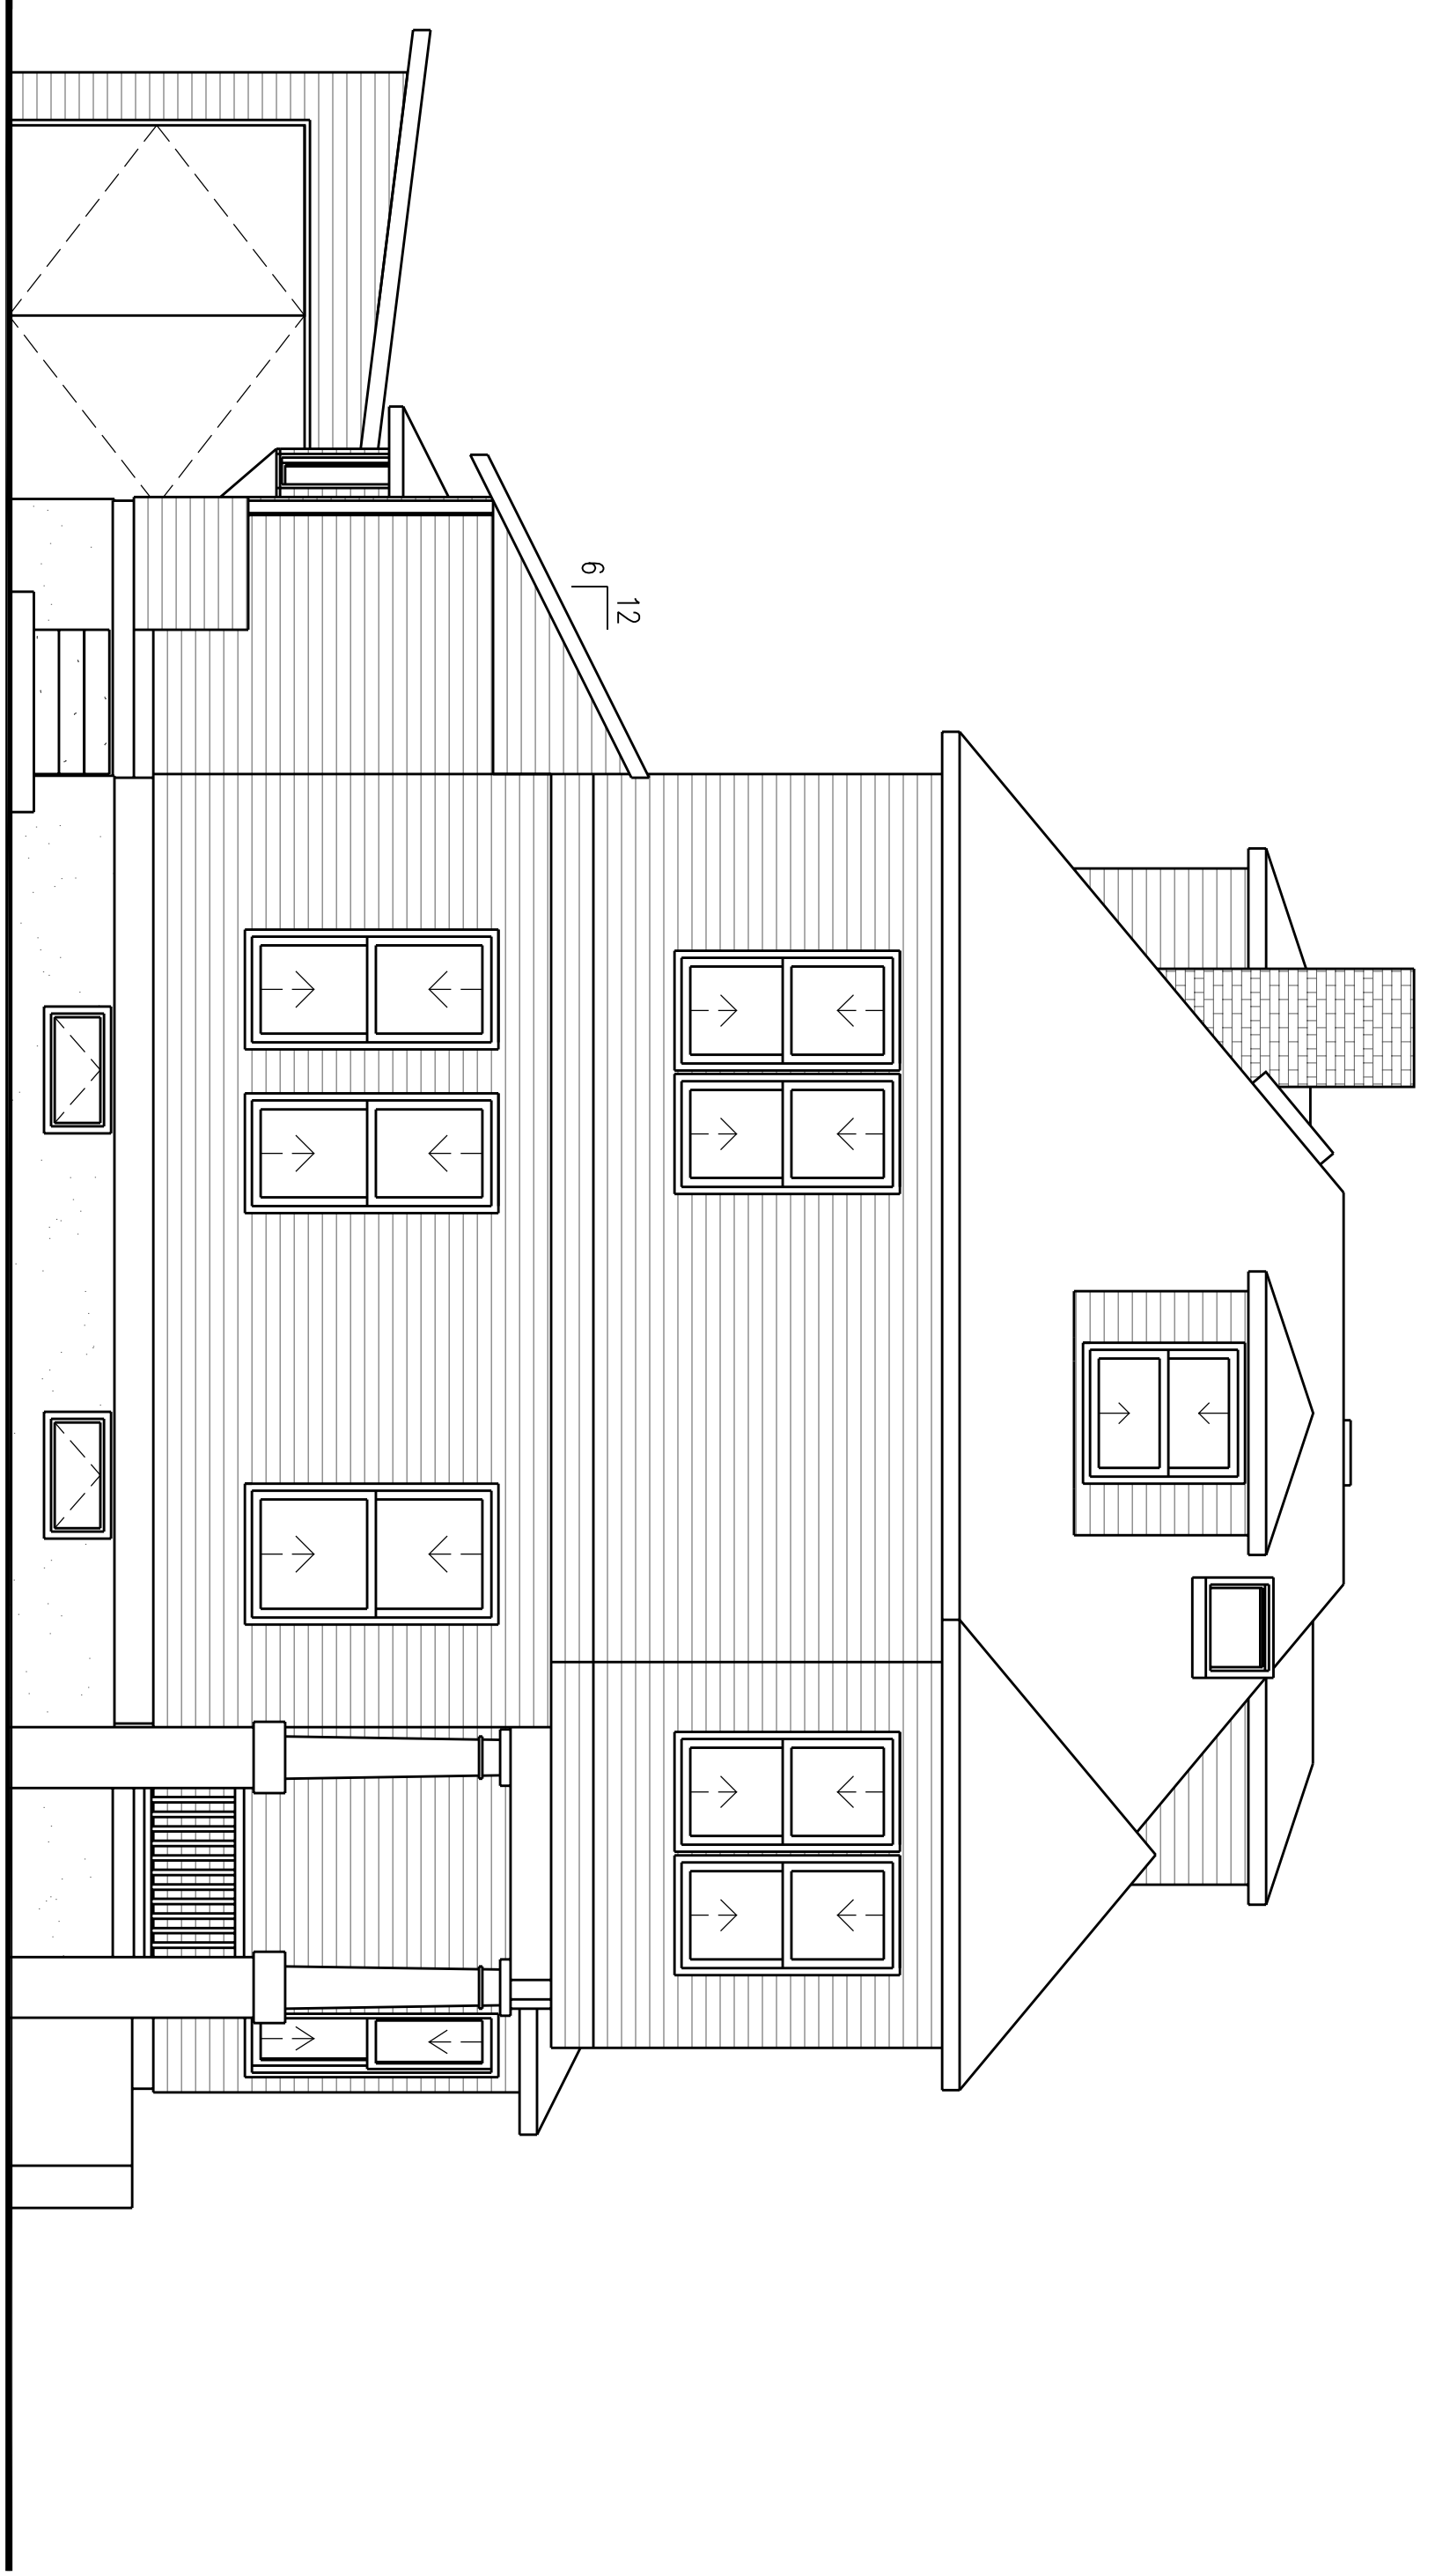

EXISTING  
EAST ELEVATION

SCALE: 1/4" = 1'-0"

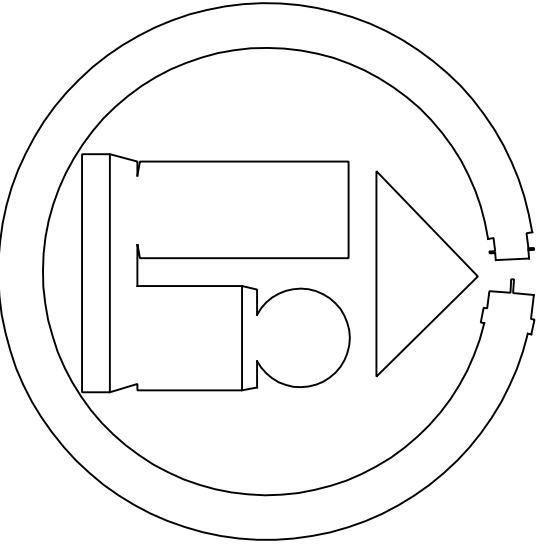


ARCHIDIGM  
Digital Support for Architects

PROJECT:  
**PALOT ALTO RESIDENCE**  
ISSUED FOR:  
PALO ALTO, CA.

DATE:  
SCALE: AS NOTED  
DRAWING TITLE:  
**EXISTING FLOOR PLAN**  
SHEET NO.


**A3.0**

SHEET\_A3.0

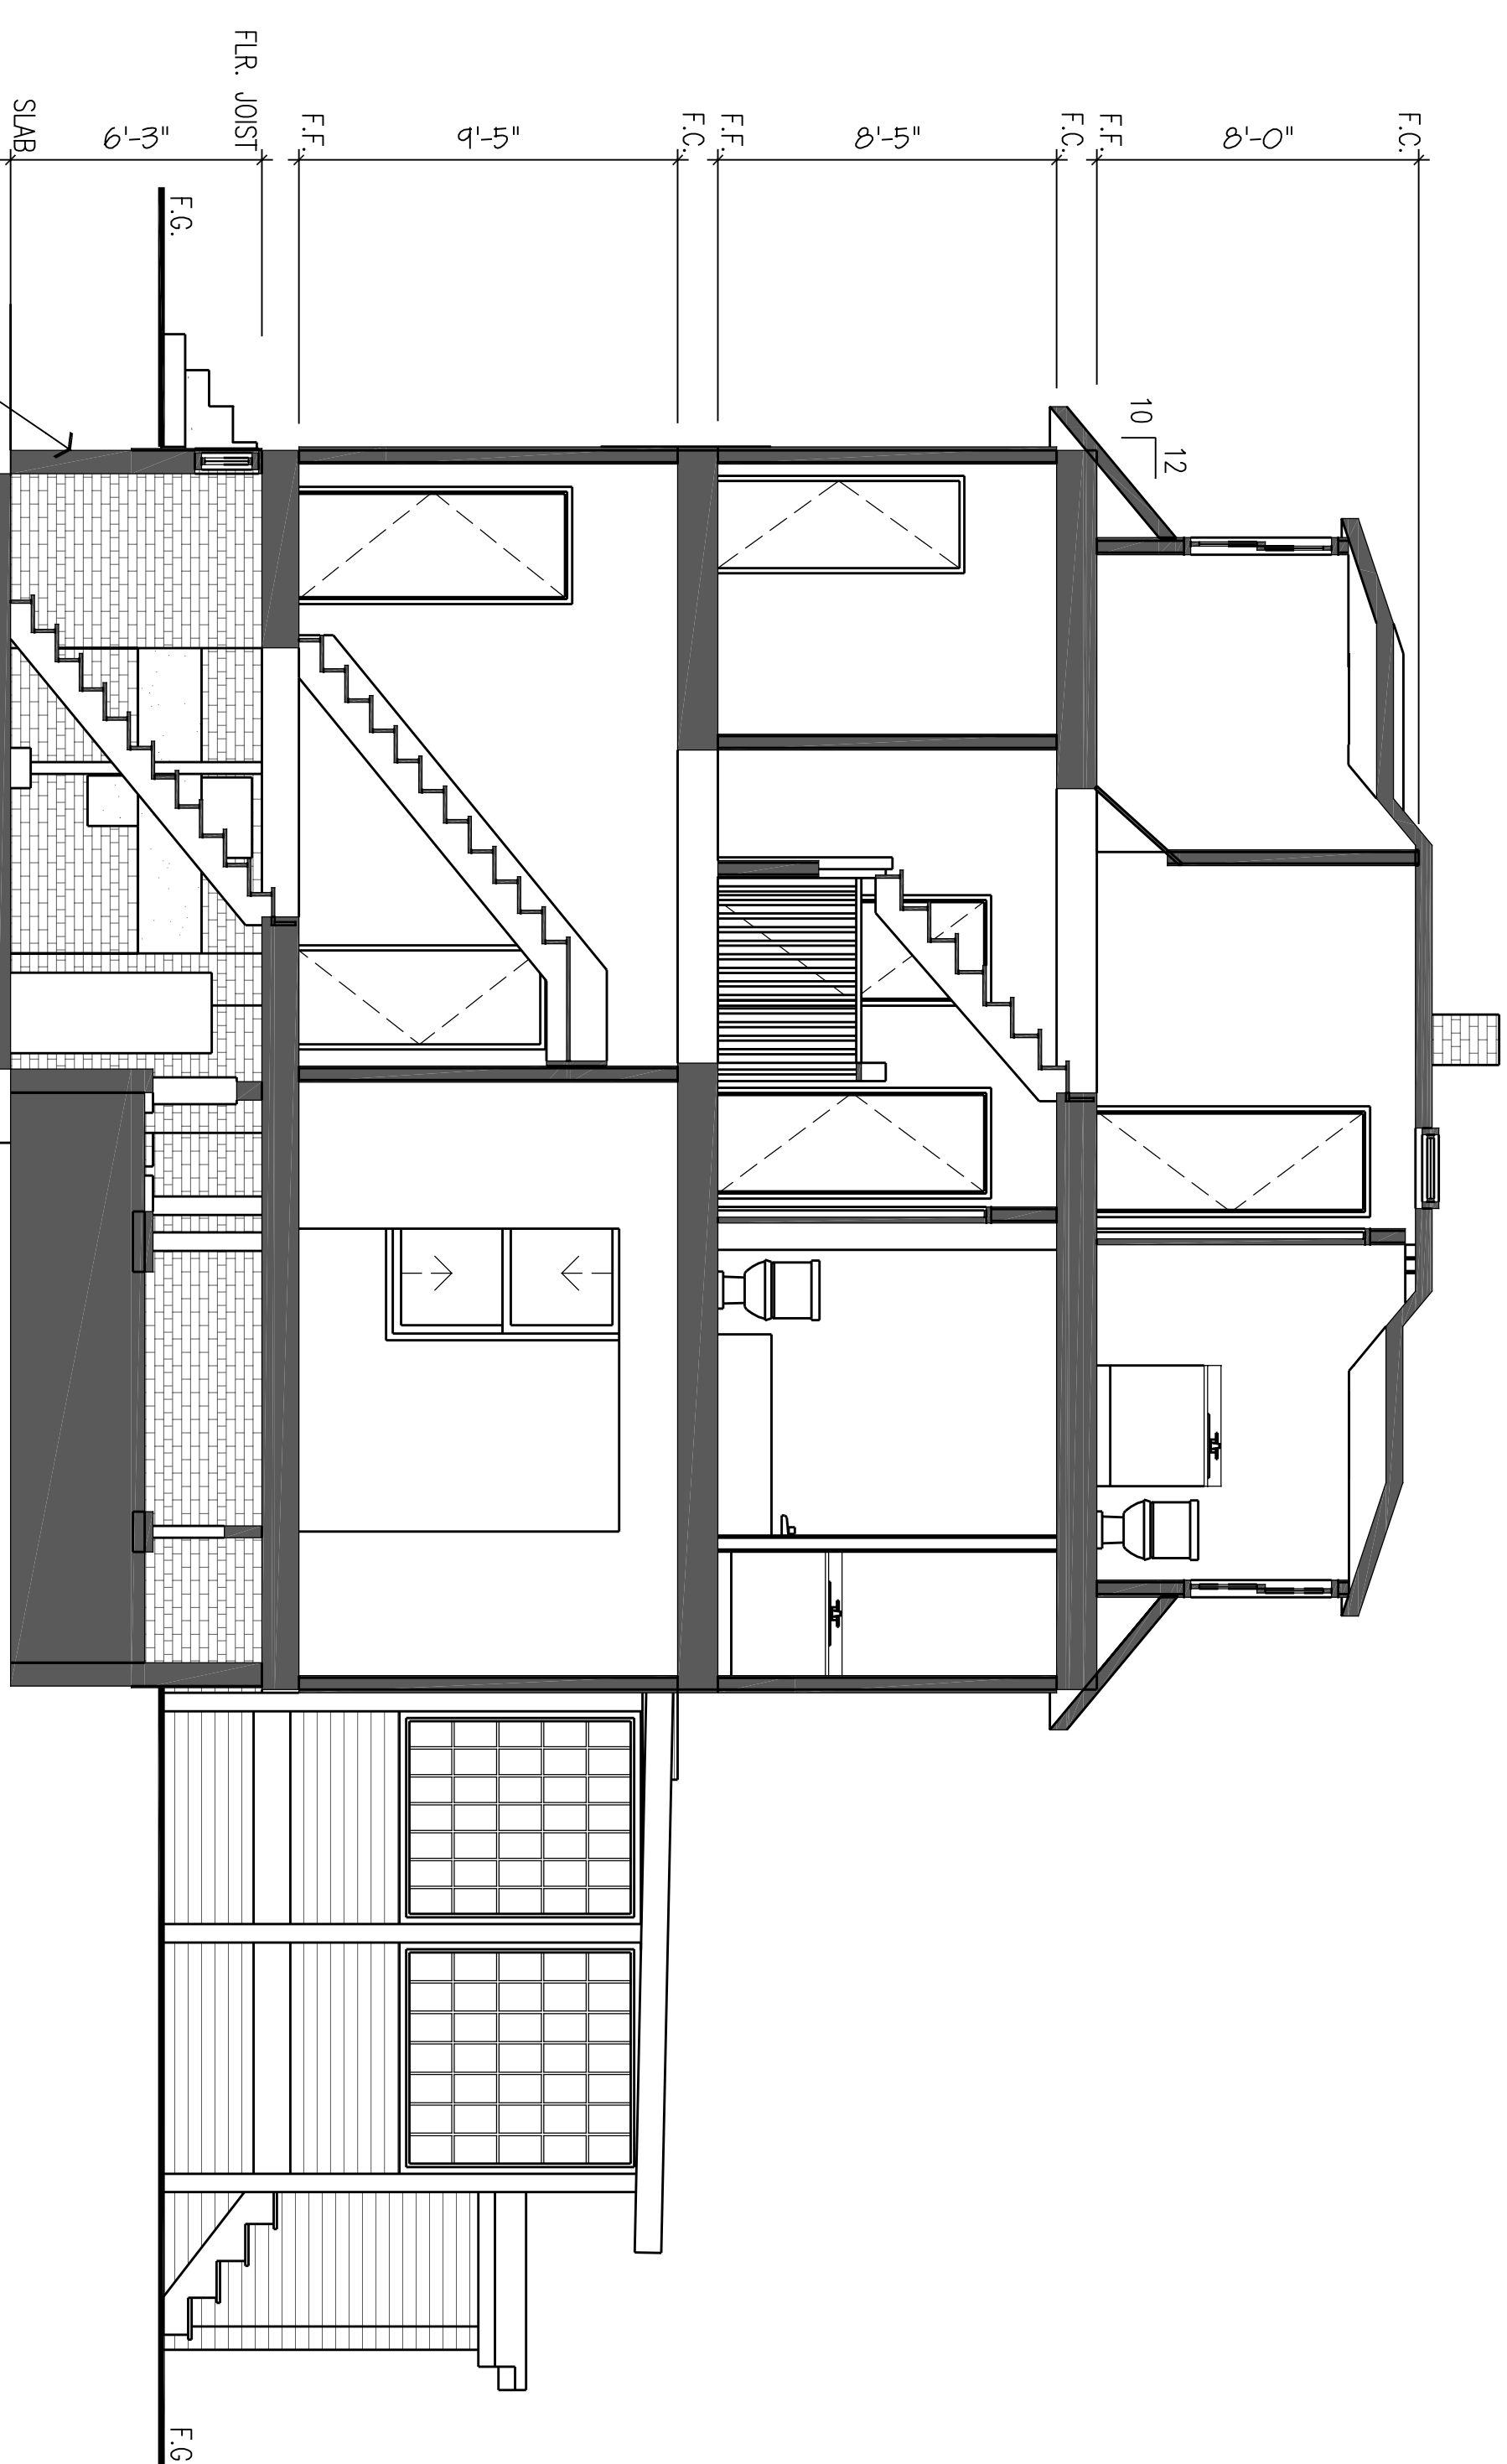


EXISTING  
SECTION A-A

SCALE: 1/4" = 1' - 0"

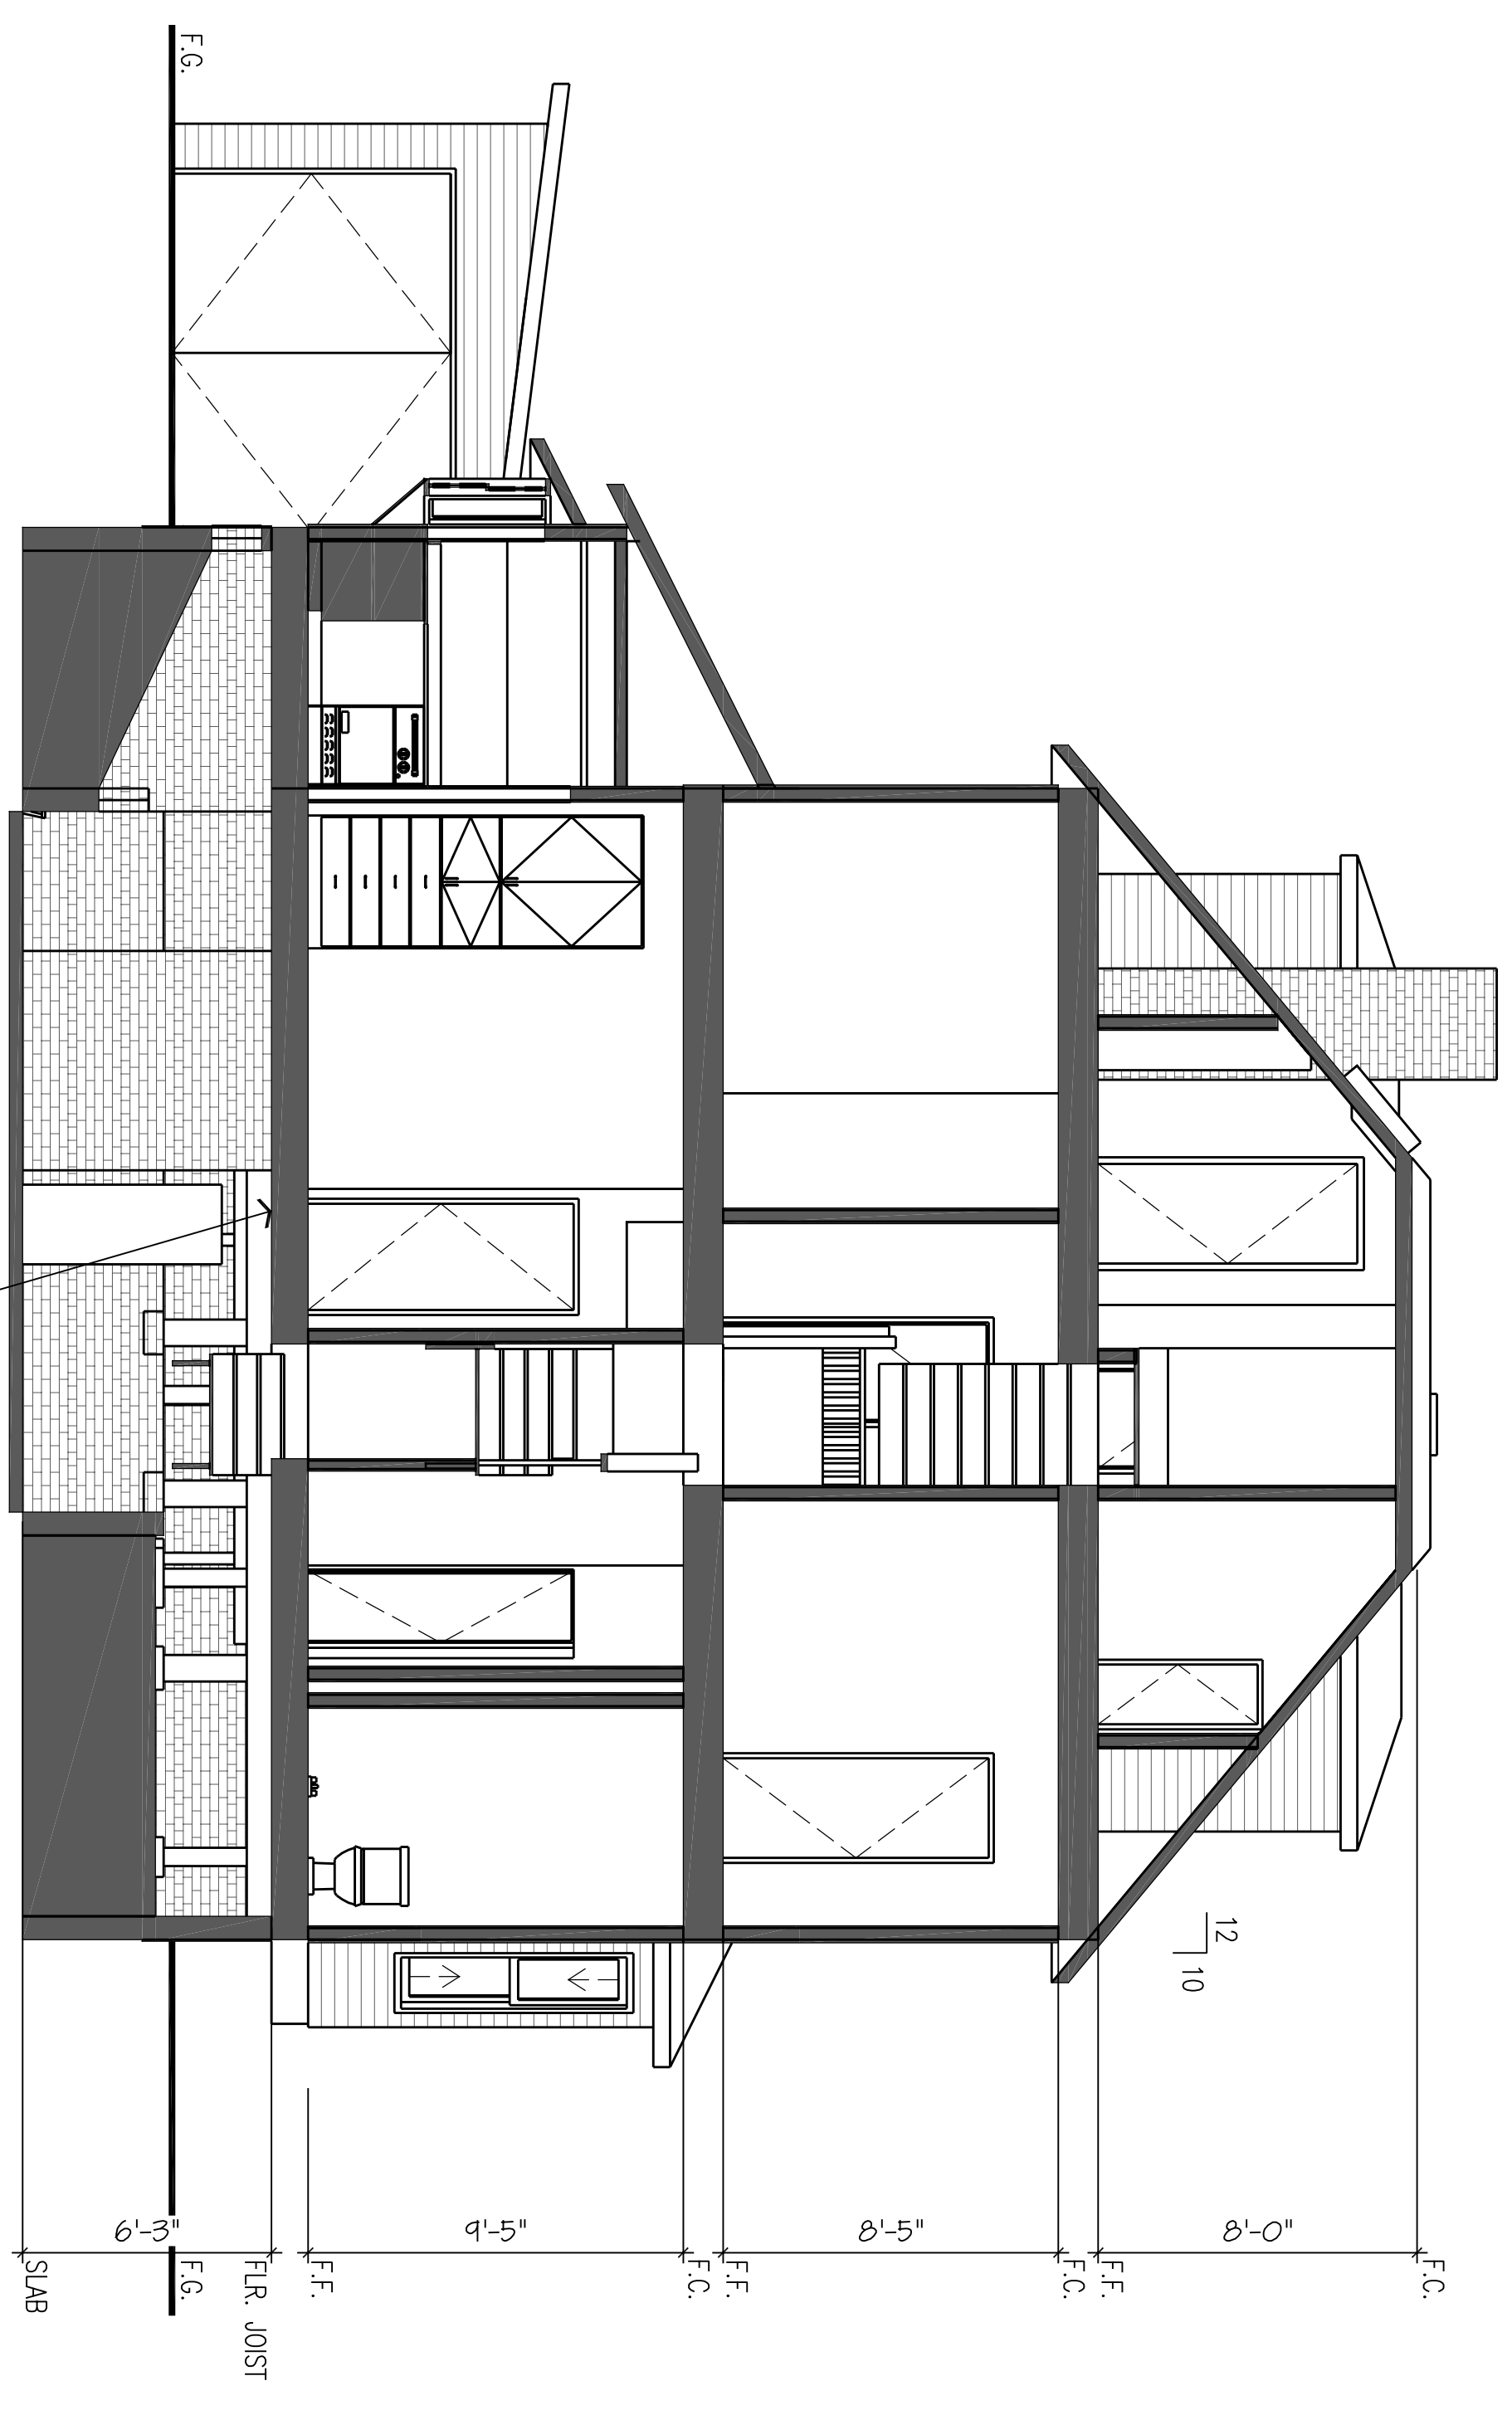

EXISTING  
SECTION B-B

SCALE: 1/4" = 1' - 0"

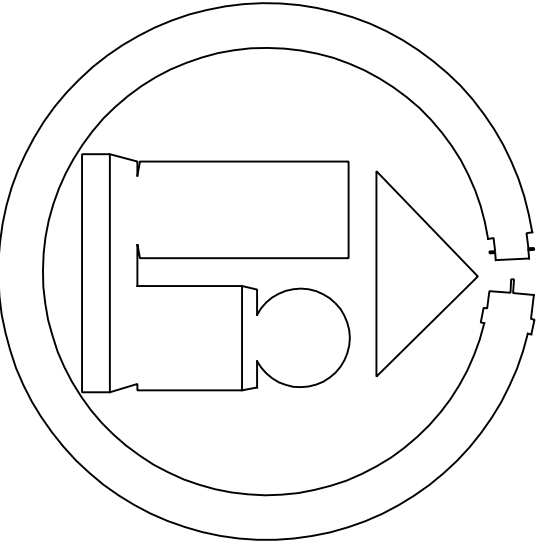

ARCHIDIGM  
Digital Support for Architects

PROJECT:  
**PALO ALTO RESIDENCE**  
ISSUED FOR:  
PALO ALTO, CA.



DATE:  
SCALE: AS NOTED  
DRAWING TITLE:  
**EXISTING SECTIONS**  
SHEET NO.

**A4.0**

SHEET\_A4.0

# ELECTRICAL LEGEND:

- ⊠ CEILING LIGHT – GENERIC FIXTURE
- ↻ DIRECTIONAL SURFACE MOUNTED CEILING LIGHT – RECESSED WALL WASHER
- SURFACE MOUNTED CEILING LIGHT – RECESSED CAN
- WALL MOUNTED LIGHT – SCOFF
- ⊙ CEILING MOUNTED EXHAUST FAN
- ⊠ CLOSET LIGHT – RECESSED CAN
- ⊠ AUTOMATIC ON/OFF SWITCH, DOOR ACTIVATED
- ⊠ 220V OUTLET
- ⊠ 110V OUTLET
- ⊠ GROUND FAULT INTERRUPT
- ⊠ WATER PROOF OUTLET
- ⊠ SWITCH
- ⊠ 2-WAY SWITCH
- ⊠ 3-WAY SWITCH
- ⊠ DIMMER SWITCH
- ⊠ TELEPHONE
- ⊠ TV
- ⊠ SMOKE DETECTOR
- ⊠ NEW HARDWIRED SMOKE DETECTOR – SEE NOTE #4
- ⊠ NEW DETECTOR – SEE NOTE #4
- ⊠ THERMOSTAT

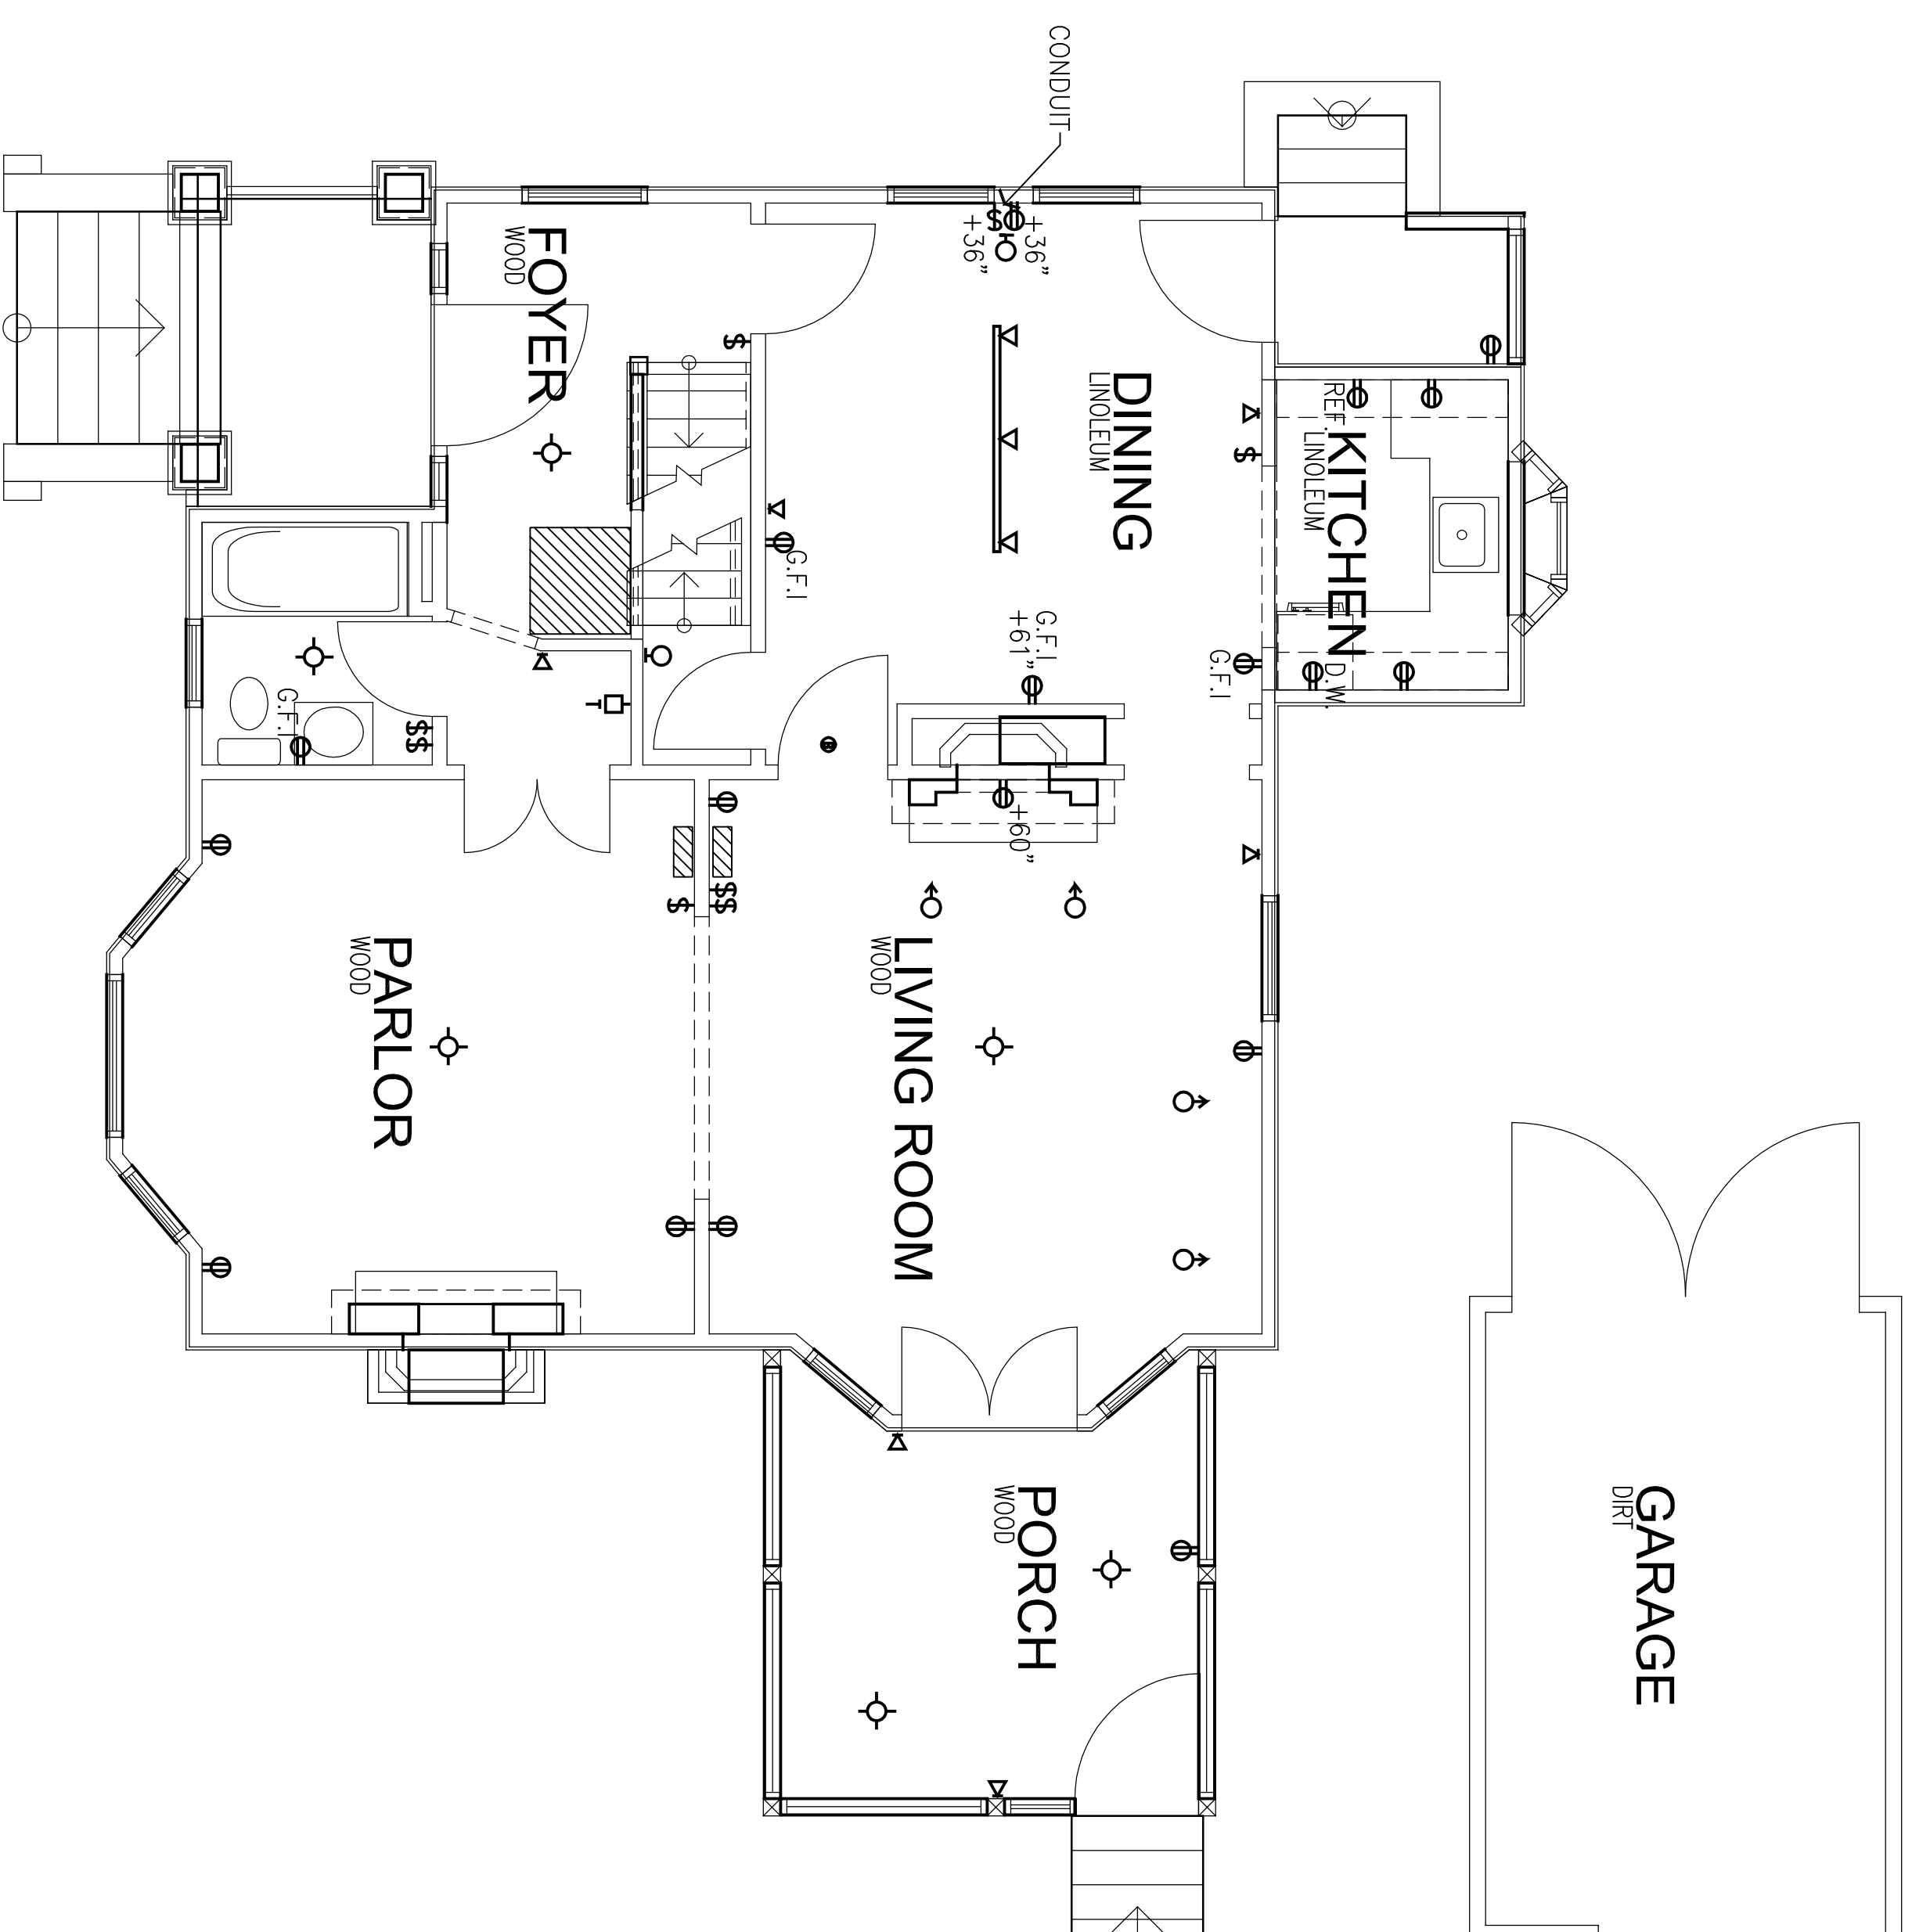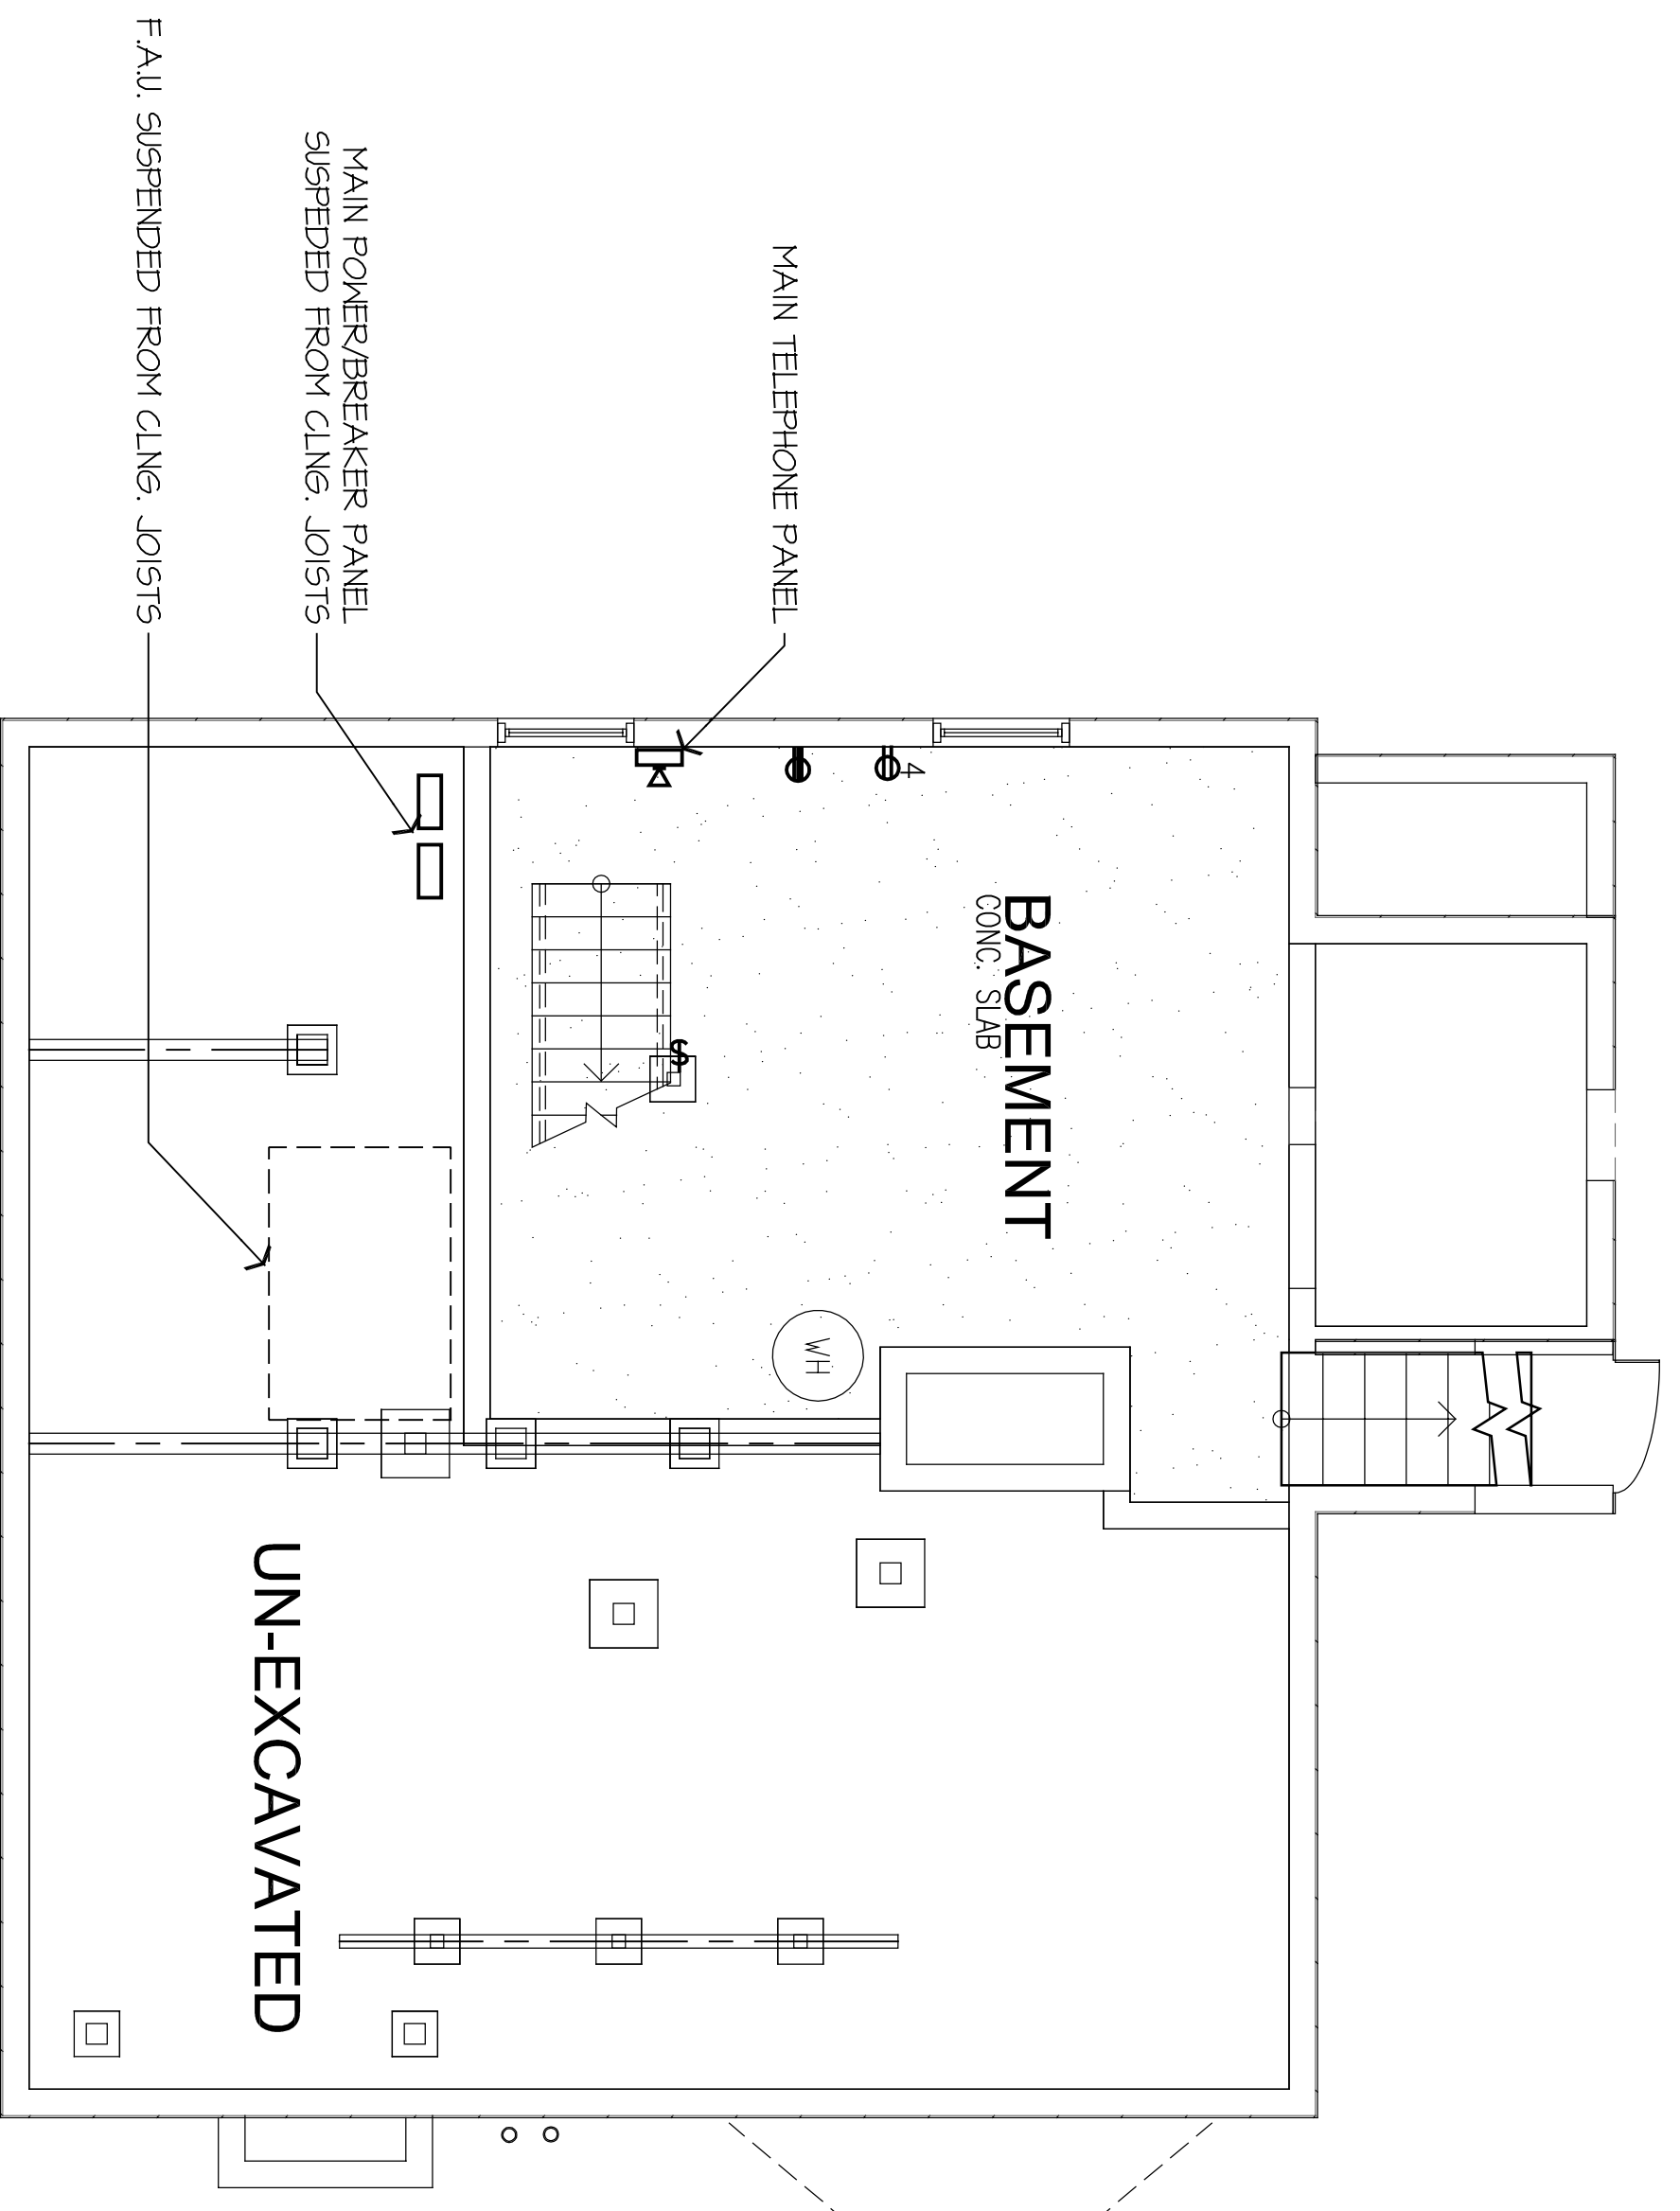


## EXISTING BASEMENT ELECTRICAL PLAN

SCALE: 1/4" = 1'-0"



## EXISTING 1ST FLOOR ELECTRICAL PLAN

SCALE: 1/4" = 1'-0"

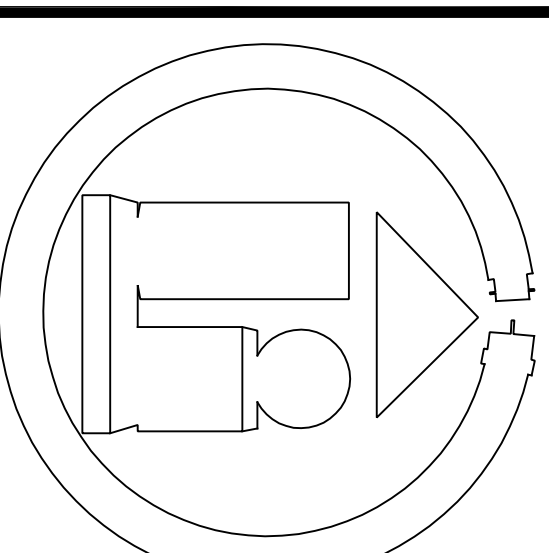


PROJECT: **PALOT ALTO RESIDENCE**  
 ISSUED FOR: **PALO ALTO, CA.**

DATE:  
 SCALE: AS NOTED  
 DRAWING TITLE:  
**EXISTING ELECT. PLAN**  
 SHEET NO.

# E1.0


# ELECTRICAL LEGEND:

- ☒ CEILING LIGHT - GENERIC FIXTURE
- ☒ DIRECTIONAL SURFACE MOUNTED CEILING LIGHT - RECESSED WALL WASHER
- ☒ SURFACE MOUNTED CEILING LIGHT - RECESSED CAN
- ☒ WALL MOUNTED LIGHT - SCOURCE
- ☒ CEILING MOUNTED EXHAUST FAN
- ☒ CLOSET LIGHT - RECESSED CAN
- ☒ CLOSET LIGHT - RECESSED CAN
- ☒ AUTOMATIC ON/OFF SWITCH, DOOR ACTIVATED
- ☒ 220V OUTLET
- ☒ 110V OUTLET
- ☒ GROUND FAULT INTERRUPT
- ☒ WATER PROOF OUTLET
- ☒ SWITCH
- ☒ 2-WAY SWITCH
- ☒ 3-WAY SWITCH
- ☒ DIMMER SWITCH
- ☒ TELEPHONE
- ☒ TV
- ☒ SMOKE DETECTOR
- ☒ NEW HARDWIRED SMOKE DETECTOR - SEE NOTE #4
- ☒ THERMOSTAT

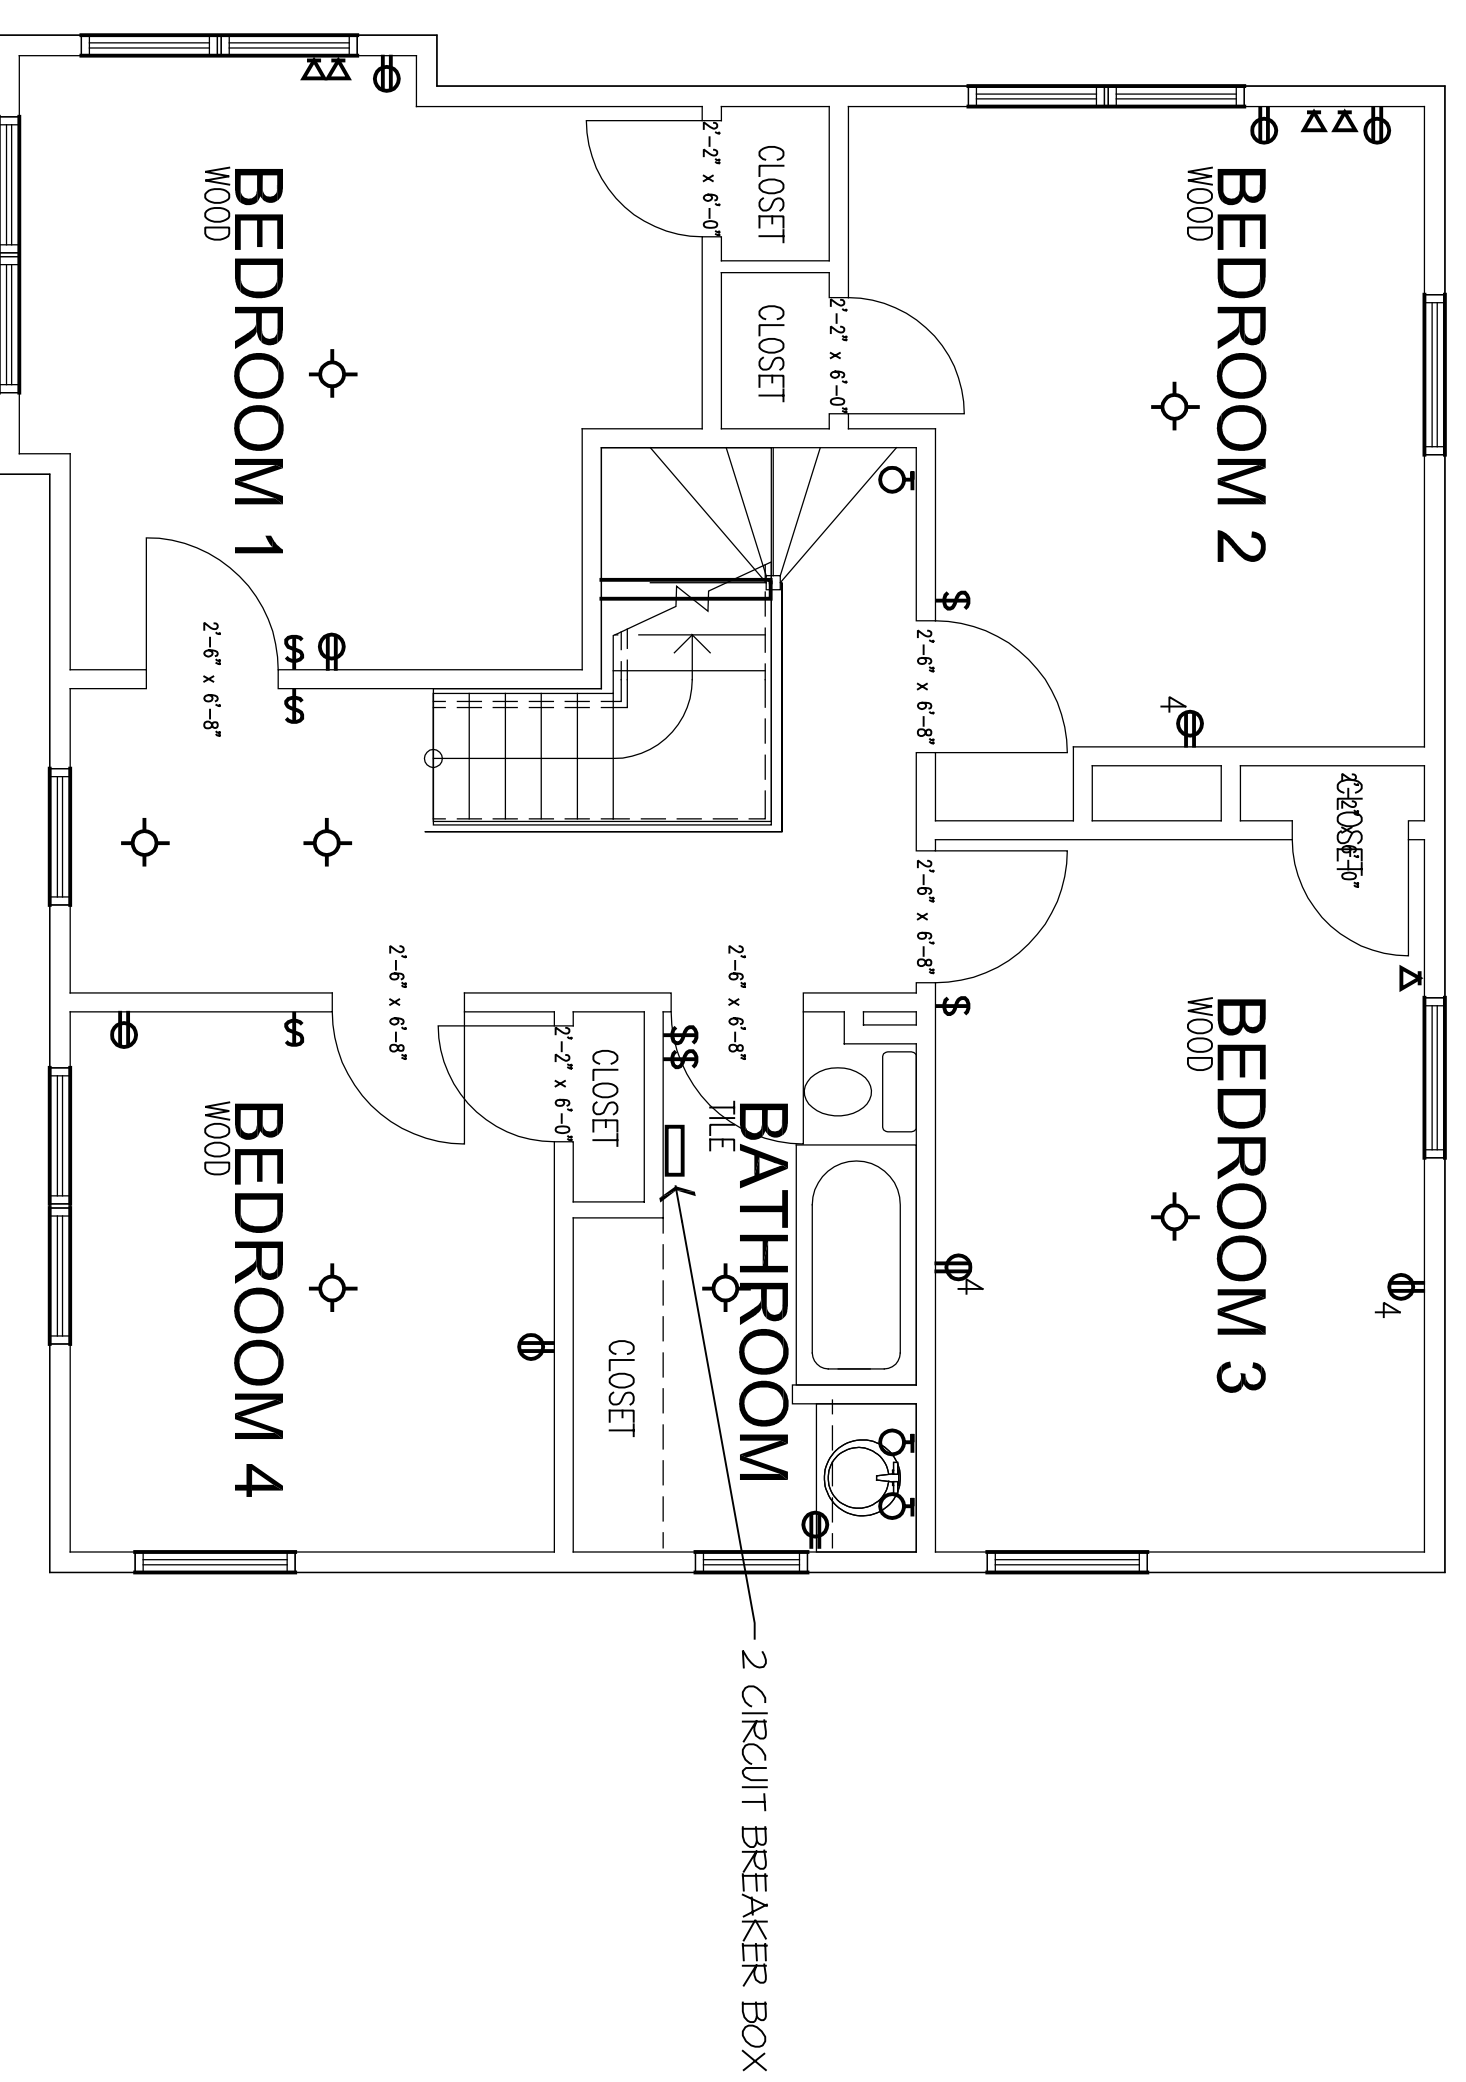


## EXISTING 2ND FLOOR ELECTRICAL PLAN

SCALE: 1/4" = 1'-0"

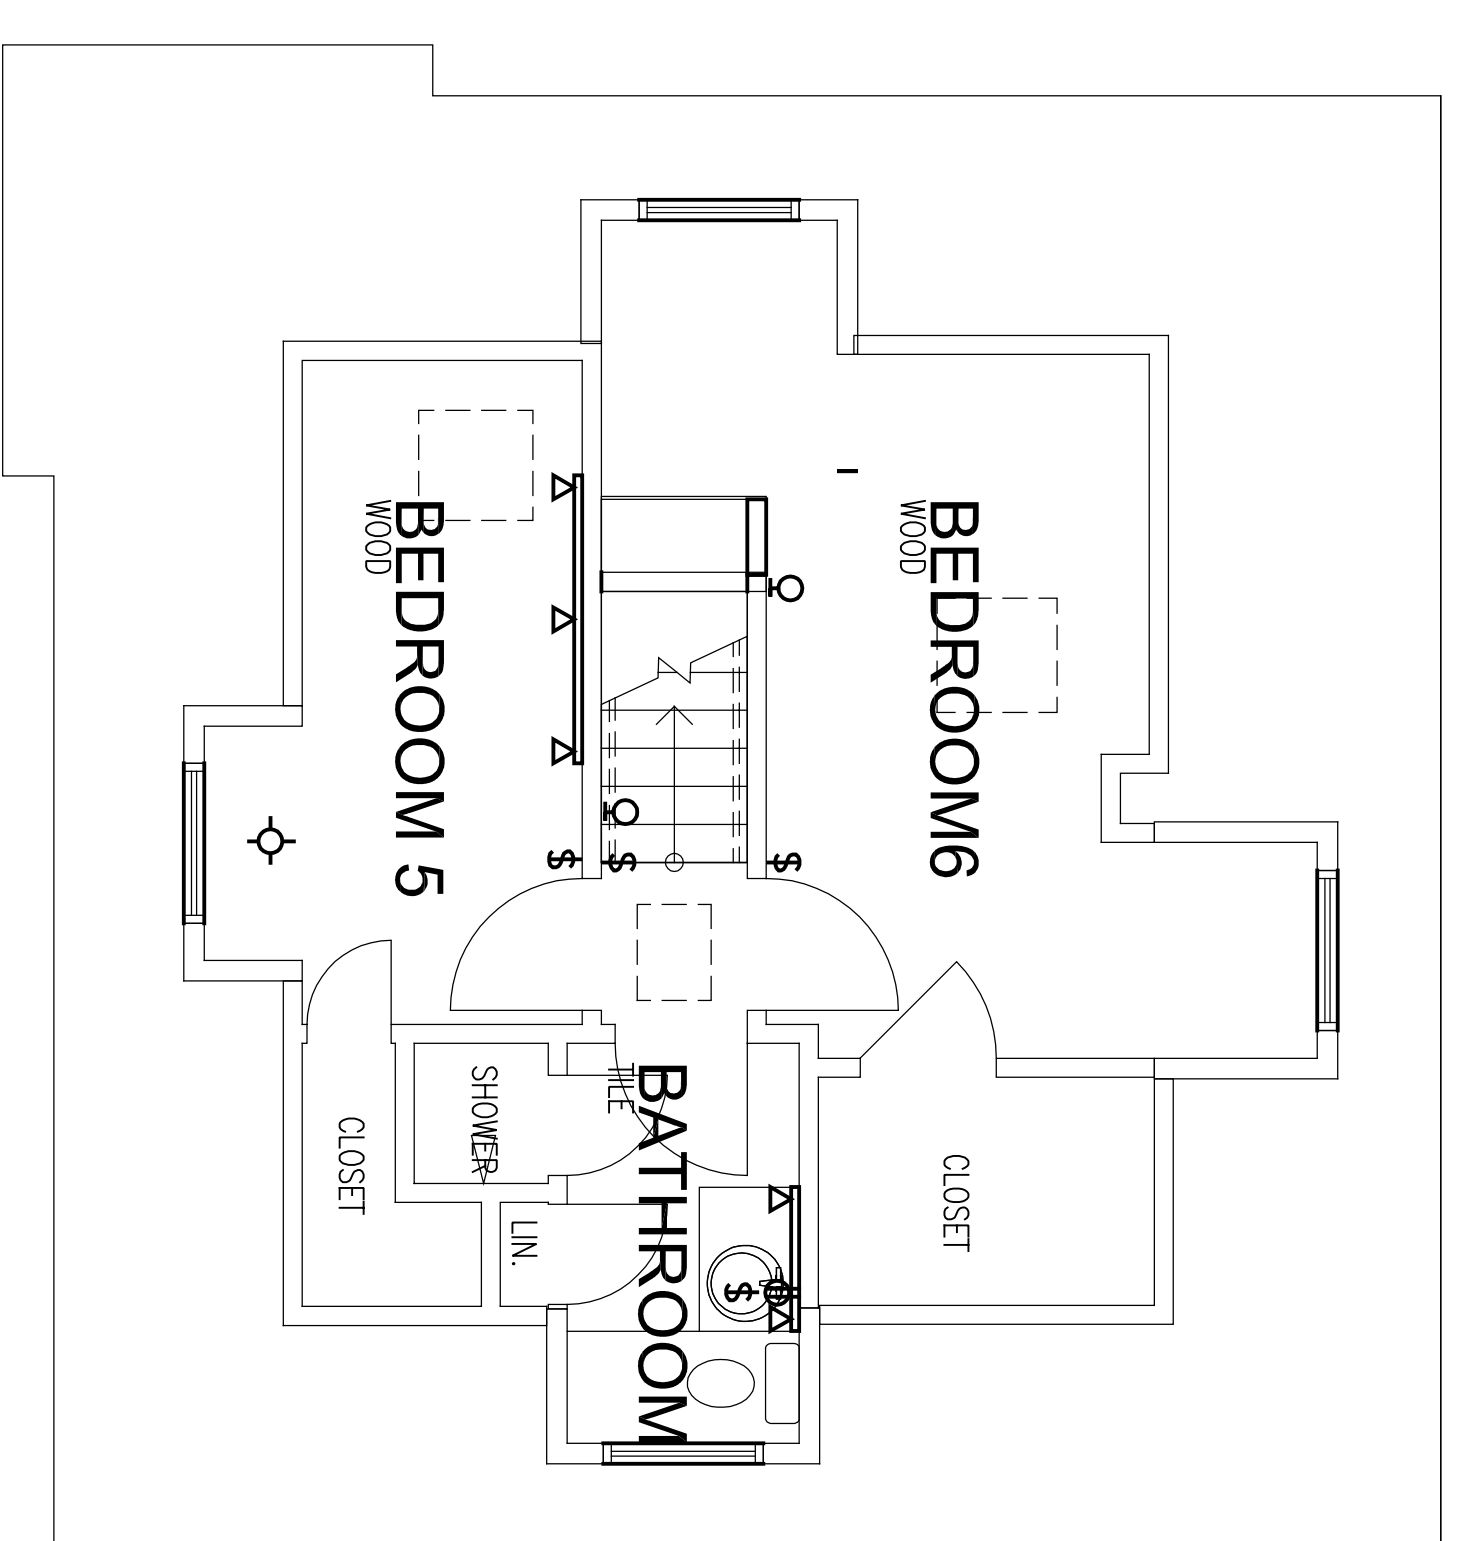

## EXISTING 3RD FLOOR ELECTRICAL PLAN

SCALE: 1/4" = 1'-0"

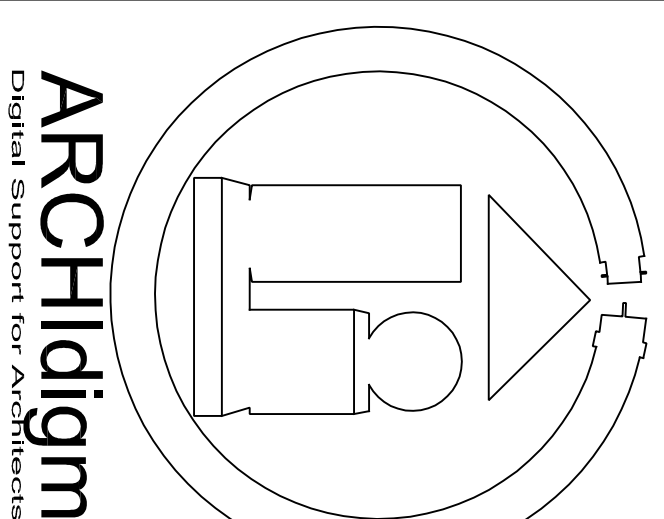

PROJECT:  
**PALOT ALTO RESIDENCE**  
ISSUED FOR:  
PALO ALTO, CA.

DATE:  
SCALE: AS NOTED  
DRAWING TITLE:  
**EXISTING  
ELECT. PLAN**  
SHEET NO.

# E1.1

SHEET E1.1